

OREGON CORNER RESTORATION FORM

SECTION 28 TOWNSHIP 5N RANGE 28E V-9

COUNTY: UMATILLA DATE 4/90

CORNER DESIGNATION

SW Corner

CONDITION REPORT ONLY
NOT FOUND
RENEWED
UNRECORDED
x SURVEYED IN
x REFERENCED OUT


PREVIOUS RENEWALS/SURVEYS, ETC.

Original survey by Davenport in 1861 under Contract #101. In 1917, in a Supplemental Plat, Eriksen found a monument.


MONUMENTS & ACCESSORIES FOUND: Condition and Source

Found a 2 1/2" Brass Cap on 1" Iron pipe, N72° 12'W 8.67 feet of the corner. I set it by double proportion in a 1978 survey for Red Leonard.

MONUMENT DETAIL

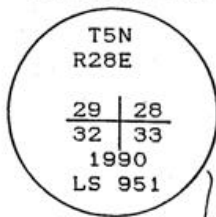

SKETCH

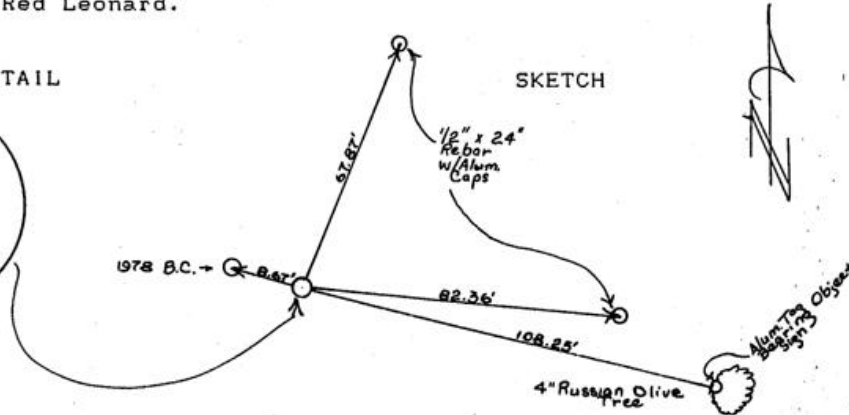

MONUMENT SET (PROCEDURES AND DESCRIPTION) By retracing Eriksen's 1917 survey I set a 1"x 30" Iron pipe with 2 3/8" Brass Cap, stamped as above, in a swamp. Placed a 16" piece of 24" P.V.C. and filled with sand to level of top Brass Cap. See Umatilla County 1989 Area One Survey.

NEW ACCESSORIES

From which I added "W.C." to my 1978 Brass Cap which Bears. N72° 12'W 8.67 feet & referenced same with steel post with Bearing Object & Witness Cor. signs attached, a 1/2"x 24" rebar with Alum. Cap stamped LS 951 Bears. N21° 36' 35"E 67.87 feet, reference same with steel post with "B0" and Witness signs attached, a 1/2"x 24" rebar with Alum. Cap Bears. S85° 00' 38"E 82.36 feet, referenced same with steel post with signs attached, an Alum. tag #951 in 4" Russian Olive tree Bears. S76° 45' 43"E 108.25 feet, also attached a Bearing Object sign to this tree.

LOCATION & COMMENTS

From just South of I 82 intersection with Power Line Rd. go East on gravel road 0.3 miles to Lane to North. Go Northerly 1 mile to corner in swamp.

COMPASS DEC. FIRM EDWARDS SURVEYING P.O. BOX 763, HERMISTON, OREGON, 97838 PARTY CHIEF D. EDWARDS NOTES WITNESS J. COPPOCK

SURVEYOR'S SEAL

REGISTERED PROFESSIONAL LAND SURVEYOR

Signature of D. Dennis Edwards

OREGON JULY 16, 1971 G. DENNIS EDWARDS 951

RECEIVED BY

Umatilla County Surveyor

Date 1-91

Rec'd By KA

No. 91-01-B