

CORNER RESTORATION FORM

Township 5N Range 28E Section 33 County UMATILLA

State OREGON Date 3/26/2014 Number X-9

Corner Designation : 1/4 CORNER SEC. 32 & 33

- Condition Report Only
- Not Found
- Renewed
- Surveyed In
- Referenced

Previous Renewals _____

Monument (s) Found: (Condition and Source)

NONE

ESTABLISHED IN RECORD OF SURVEY 08-136-B BUT NOT


MONUMENTED

Accessories Found:

NONE

MONUMENT DETAIL

Found Set

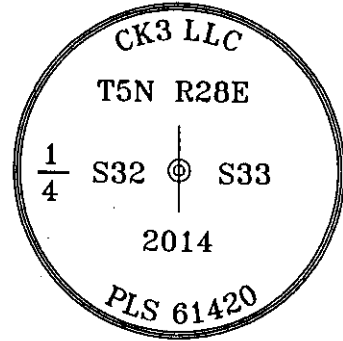

Monument & Accessories Set (Procedure and Description)

SET 3" ALUMINUM CAP ON 5/8" REBAR 2.5' BELOW FIELD GRADE MARKED AS SHOWN, SET BY RETRACEMENT OF RECORD OF SURVEY 08-136-B. ALL BEARINGS SHOWN HERE ARE BASED ON SURVEY NO. 14-030-C

SET 5/8" REBAR & CAP PLS 61420 AT GRADE N81°02'E 325.20, NEAR PIVOT BASE AND STAND PIPE.

SET 5/8" REBAR & CAP PLS 61420 AT GRADE N38°32'W 52.11, NEAR IRRIGATION VALVE STAND PIPE.

SET 5/8" REBAR & CAP PLS 61420 AT GRADE S25°22'E 1437.86, NEAR OLD WINDMILL BASE.

SET 5/8" REBAR & CAP PLS 61420 AT GRADE S18°29'W 1188.91 NEAR PIVOT BASE.

Sketch of Monument, Accessories and General Area

REGISTERED PROFESSIONAL LAND SURVEYOR

Lance Clark

OREGON
MAY 10, 2011
LANCE CLARK
61420

RENEWS: 6/30/2015

Agency:
CK3, LLC
945 W. ORCHARD
HERMISTON OREGON 97838
OFFICE: 541-567-2345
FAX: 541-567-2305
WEB: CK3LLC.NET
Field Book # 0-289

COUNTY SURVEYOR RECORDING INFO

Received _____

Filed _____

Survey No. _____

Drawing No. _____

Index No. _____