

# OREGON CORNER RESTORATION FORM

SECTION 7, 12, 13, 18 TOWNSHIP 5 NORTH RANGE 29 EAST, RANGE 28 EAST J-1  
 COUNTY : UMATILLA DATE DEC/22

CORNER DESIGNATION  
 SECTION CORNER

- CONDITION REPORT ONLY
- NOT FOUND
- RENEWED
- UNCOVERED
- SURVEYED IN
- REFERENCED

PREVIOUS RENEWALS / SURVEYS, ETC.


SURVEYED IN 1861 BY DAVENPORT UNDER CONTRACT #101, HE SET POST AND MADE MOUND.  
 IN 1959 U.S. CORPS OF ENGINEERS SET A 3" BRASS CAP IN CONCRETE.

MONUMENTS AND ACCESSORIES FOUND: CONDITION AND SOURCE


FOUND 2 1/2" BRASS CAP STAMPED AS BELOW.  
 FOUND 3" BRASS CAP STAMPED AS BELOW, DISPLACED FROM CONCRETE AND LAYING ON GROUND.  
 FOUND 5/8" IRON ROD WITH YELLOW PLASTIC CAP STAMPED LS 951 BEARS N 56°15'23" E, 134.84'.  
 FOUND 5/8" IRON ROD WITH YELLOW PLASTIC CAP STAMPED LS 951 BEARS N 29°37'03" W, 414.50'.

MONUMENT DETAIL

FOUND 3" BRASS CAP  
 LAYING ON GROUND

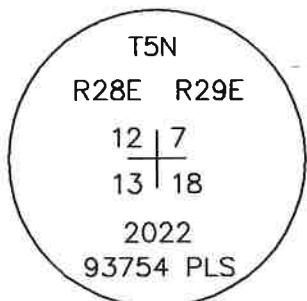

N.T.S

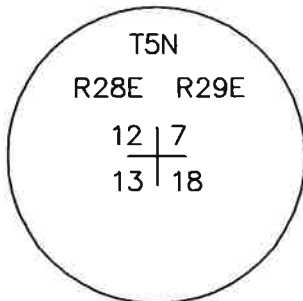

NAD 83/91  
 OREGON STATE PLANE  
 INTERNATIONAL FEET

824894.65  
 8521513.34

MONUMENT SET ( PROCEDURES AND DESCRIPTION )

NEW ACCESSORIES FROM WHICH

SET 5/8" X 30" IRON ROD WITH YELLOW PLASTIC CAP STAMPED PLS LS 48509 BEARS N 82°45'15" W, 166.43'.  
 SET 5/8" X 30" IRON ROD WITH YELLOW PLASTIC CAP STAMPED PLS LS 48509 BEARS S 64°31'27" E, 48.63'.

LOCATION AND COMMENTS

FROM NORTHWEST CORNER OF  
 WANAKET WILDLIFE AREA ON MCNARY  
 BEACH ROAD, GO EAST ALONG THE  
 NORTHERLY BOUNDARY +/- 1.0  
 MILE AND THEN GO NORTH +/-  
 0.25 MILE TO CORNER.

FIRM/AGENCY

PRIMM LAND SURVEYING, INC.  
 P.O. BOX 1322  
 HERMISTON, OREGON 97838

LAND SURVEYOR

BRIT L. PRIMM

WITNESS

KEITH P. PRIMM

SURVEYOR'S SEAL

REGISTERED  
 PROFESSIONAL  
 LAND SURVEYOR

*Brit L. Primm*

OREGON  
 JULY 13, 1999  
 BRIT L. PRIMM  
 48509

EXPIRATION DATE: 12/31/24

23-012-C