

# OREGON CORNER RESTORATION FORM

SECTION 16, 21 TOWNSHIP 5 NORTH RANGE 29 EAST  
COUNTY : UMATILLA DATE DEC/22

N-11

CORNER DESIGNATION

1/4 CORNER

CONDITION REPORT ONLY

NOT FOUND

RENEWED

UNCOVERED

SURVEYED IN

REFERENCED


PREVIOUS RENEWALS / SURVEYS, ETC.

SURVEYED IN 1861 BY DAVENPORT UNDER CONTRACT #101, HE SET POST AND MADE MOUND.  
IN 1991 LS 951 SET A 2 3/8" BRASS CAP.

MONUMENTS AND ACCESSORIES FOUND: CONDITION AND SOURCE

FOUND 2 3/8" BRASS CAP STAMPED AS BELOW.  
FOUND 2" IRON PIPE BEARS S 88°29' W, 34.41'.  
FOUND 1/2" IRON ROD WITH ALUMINUM TAG STAMPED LS 951 BEARS N 88°30'41" E, 8.24'.  
FOUND 5/8" IRON ROD WITH YELLOW PLASTIC CAP STAMPED LS 951 BEARS N 14°33'44" E, 8.70'.  
FOUND 5/8" IRON ROD WITH YELLOW PLASTIC CAP STAMPED LS 951 BEARS N 88°56'19" W, 37.45'.  
FOUND 5/8" IRON ROD WITH YELLOW PLASTIC CAP STAMPED LS 951 BEARS S 18°24'20" E, 21.65'.

MONUMENT DETAIL

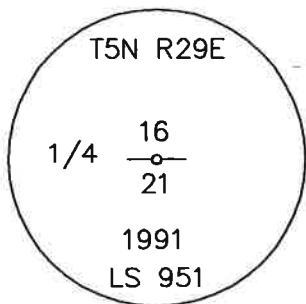

N.T.S

NAD 83/91  
OREGON STATE PLANE  
INTERNATIONAL FEET

819732.64  
8534871.31

MONUMENT SET ( PROCEDURES AND DESCRIPTION )

NEW ACCESSORIES FROM WHICH

LOCATION AND COMMENTS

FROM INTERSECTION OF SALMON  
POINT DRIVE AND HIGHWAY 730 GO  
WEST +/- 0.5 MILES AND NORTH  
+/- 0.4 MILES TO CORNER.

FIRM/AGENCY

PRIMM LAND SURVEYING, INC.  
P.O. BOX 1322  
HERMISTON, OREGON 97838

LAND SURVEYOR

BRIT L. PRIMM

WITNESS

KEITH P. PRIMM

SURVEYOR'S SEAL

REGISTERED  
PROFESSIONAL  
LAND SURVEYOR

OREGON  
JULY 13, 1999  
BRIT L. PRIMM  
48509

EXPIRATION DATE: 12/31/24