

# OREGON CORNER RESTORATION FORM

SECTION 23, 24, 25, 26 TOWNSHIP 5 NORTH RANGE 29 EAST

R-21

COUNTY : UMATILLA DATE DEC/22

CORNER DESIGNATION

SECTION CORNER

CONDITION REPORT ONLY

NOT FOUND

RENEWED

UNCOVERED

SURVEYED IN

REFERENCED


PREVIOUS RENEWALS / SURVEYS, ETC.

SURVEYED IN 1861 BY DAVENPORT UNDER CONTRACT #101, HE SET POST AND MADE MOUND.  
IN 2000 PLS 1106 SET A 2 1/2" BRASS CAP.

MONUMENTS AND ACCESSORIES FOUND: CONDITION AND SOURCE

FOUND 2 1/2" BRASS CAP 1.5' BELOW GRADE STAMPED AS BELOW.  
FOUND A SILVER "DEEP ONE" MAGNET MARKER 15" BELOW GARDE BEARS N 42° E, 31.0'.  
FOUND A PURPLE "DEEP ONE" MAGNET MARKER 15" BELOW GARDE BEARS S 50° E, 30.7'.  
FOUND A BLUE "DEEP ONE" MAGNET MARKER 15" BELOW GARDE BEARS S 43° W, 32.5'.  
FOUND A ORANGE "DEEP ONE" MAGNET MARKER 15" BELOW GARDE BEARS N 44° W, 30.4'.

MONUMENT DETAIL

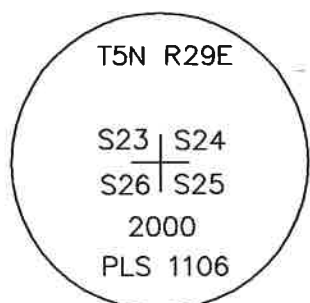

NAD 83/91  
OREGON STATE PLANE  
INTERNATIONAL FEET

814718.08  
8548189.54

MONUMENT SET ( PROCEDURES AND DESCRIPTION )

NEW ACCESSORIES FROM WHICH

LOCATION AND COMMENTS

FROM BRIDGE CROSSING OVER  
IRRIGATION CANAL IN THE  
NORTHWEST CORNER OF SECTION 25  
GO CLOCKWISE AROUND A CROP  
CIRCLE +/- 1700 FEET. CORNER  
FALLS IN CROP EAST +/- 190  
FEET.

FIRM/AGENCY

PRIMM LAND SURVEYING, INC.  
P.O. BOX 1322  
HERMISTON, OREGON 97838

LAND SURVEYOR

BRIT L. PRIMM

WITNESS

KEITH P. PRIMM

SURVEYOR'S SEAL

REGISTERED  
PROFESSIONAL  
LAND SURVEYOR

*Brit L. Primm*  
OREGON  
JULY 13, 1999  
BRIT L. PRIMM  
48509

EXPIRATION DATE: 12/31/24