

# OREGON CORNER RESTORATION FORM

SECTION 24, 25 TOWNSHIP 5 NORTH RANGE 29 EAST  
COUNTY : UMATILLA DATE DEC/22

R-23

CORNER DESIGNATION

1/4 CORNER

- CONDITION REPORT ONLY
- NOT FOUND
- RENEWED
- UNCOVERED
- SURVEYED IN
- REFERENCED


PREVIOUS RENEWALS / SURVEYS, ETC.

SURVEYED IN 1861 BY DAVENPORT UNDER CONTRACT #101, HE SET POST AND MADE MOUND.  
IN 2005 LS 951 SET 2 3/8" BRASS CAP.

MONUMENTS AND ACCESSORIES FOUND: CONDITION AND SOURCE

FOUND 2 3/8" BRASS CAP STAMPED AS BELOW.  
FOUND 5/8" IRON ROD WITH PLASTIC CAP STAMPED LS 951 BEARS S 41°13'32" W, 1217.82'.  
FOUND 5/8" IRON ROD WITH PLASTIC CAP STAMPED LS 951 BEARS S 76°57'57" E, 1738.59'.

MONUMENT DETAIL

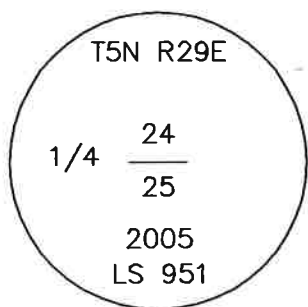

NAD 83/91  
OREGON STATE PLANE  
INTERNATIONAL FEET

814731.87  
8550814.36

MONUMENT SET ( PROCEDURES AND DESCRIPTION )

NEW ACCESSORIES FROM WHICH

SET 5/8" X 30" IRON ROD WITH YELLOW PLASTIC CAP STAMPED PLS LS 48509 BEARS N 41°14'16" E, 441.76'.  
SET 5/8" X 30" IRON ROD WITH YELLOW PLASTIC CAP STAMPED PLS LS 48509 BEARS S 78°20'09" W, 524.44'.

LOCATION AND COMMENTS

FROM INTERSECTION OF COLD SPRINGS HIGHWAY AND WALLS ROAD GO SOUTHWESTERLY ALONG WALLS ROAD +/- 1.3 MILES TO THE TANGENT OF A PIVOT WITH WALLS ROAD THEN GO CLOCKWISE AROUND SAID PIVOT +/- 1600 FEET TO THE TANGENT OF 2 PIVOTS THEN GO COUNTER CLOCKWISE AROUND SECOND PIVOT +/- 1250 FEET. CORNER FALLS SOUTHERLY +/- 240 FEET INTO SECOND PIVOT.

FIRM/AGENCY

PRIMM LAND SURVEYING, INC.  
P.O. BOX 1322  
HERMISTON, OREGON 97838

LAND SURVEYOR

BRIT L. PRIMM

WITNESS

KEITH P. PRIMM

SURVEYOR'S SEAL

REGISTERED  
PROFESSIONAL  
LAND SURVEYOR

OREGON  
JULY 13, 1999  
BRIT L. PRIMM  
48509

EXPIRATION DATE: 12/31/24