

OREGON CORNER RESTORATION FORM

SECTION 25, 26 TOWNSHIP 5 NORTH RANGE 29 EAST
COUNTY : UMATILLA DATE DEC/22

T-21

CORNER DESIGNATION

1/4 CORNER

CONDITION REPORT ONLY

NOT FOUND

RENEWED

UNCOVERED

SURVEYED IN

REFERENCED

PREVIOUS RENEWALS / SURVEYS, ETC.

SURVEYED IN 1861 BY DAVENPORT UNDER CONTRACT #101, HE SET POST AND MADE MOUND.
IN 2005 LS 951 SET A 2 3/8" BRASS CAP.

MONUMENTS AND ACCESSORIES FOUND: CONDITION AND SOURCE

FOUND 2 3/8" BRASS CAP STAMPED AS BELOW.


FOUND 5/8" IRON ROD WITH YELLOW PLASTIC CAP STAMPED LS 951 BEARS N 38°47'27" E, 660.10'.

FOUND 5/8" IRON ROD WITH YELLOW PLASTIC CAP STAMPED LS 951 BEARS N 16°44'52" E, 887.62'.

FOUND 5/8" IRON ROD WITH YELLOW PLASTIC CAP STAMPED LS 951 BEARS S 53°44'23" W, 493.66'.

FOUND CONCRETE NAIL IN PIVOT PAD BEARS N 36°34'05" W, 514.92'.

MONUMENT DETAIL

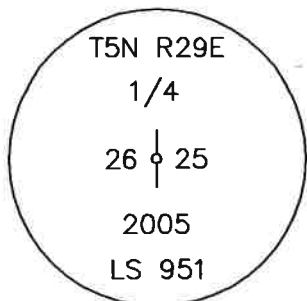

N.T.S

NAD 83/91
OREGON STATE PLANE
INTERNATIONAL FEET

812065.70
8548221.52

MONUMENT SET (PROCEDURES AND DESCRIPTION)

NEW ACCESSORIES FROM WHICH

LOCATION AND COMMENTS

FROM EAST-WEST WALLS ROAD TO
WHERE WALLS ROAD ANGLES AND
GOES NORTHEAST, GO IN A
COUNTER CLOCKWISE DIRECTION
AROUND A CROP CIRCLE +/- 0.67
MILES, CORNER FALLS NORTH +/-
425 FEET IN A HALF CIRCLE.

FIRM/AGENCY

PRIMM LAND SURVEYING, INC.
P.O. BOX 1322
HERMISTON, OREGON 97838

LAND SURVEYOR

BRIT L. PRIMM

SURVEYOR'S SEAL

REGISTERED
PROFESSIONAL
LAND SURVEYOR

OREGON
JULY 13, 1999
BRIT L. PRIMM
48509

EXPIRATION DATE: 12/31/24