


CERTIFIED RECORD OF LAND CORNER MONUMENTATION

History of original corner establishment:

Not previously set.

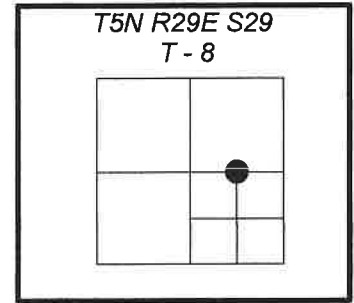

Description of corner evidence found:


N/A

Description of monument and accessories I established to perpetuate original location of this corner:

At a mid-point position; I set a 5/8 x 30 inch iron rod with a 2 inch aluminum cap mkd. as shown, in the center of Spearman Road, flush with the pavement.

From which:

- (RM 1) A 2 1/2 inch long MAG nail with a 1 1/2 inch stainless steel washer mkd.: WALLOWA ASSOCIATES LS 91201, in SW'ly face of power pole #297505, bears N 77°52' E, 88.88 ft. dist. to the face of washer.
- (RM 2) A 2 1/2 inch long MAG nail with a 1 1/2 inch stainless steel washer mkd.: WALLOWA ASSOCIATES LS 91201, in NW'ly face of power pole #297401, bears S 20°14' E, 56.74 ft. dist. to the face of washer.

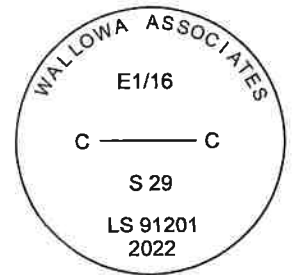

NAD 83 Geodetic Position
Lat. 45°53'09.58363" N
Long. 119°12'29.85488" W

Established by: Trimble RTK

I hereby certify that the corner is monumented and accessories taken as described, using dual frequency carrier-phase GNSS receivers.

Witnesses: Kristina Powell, David Quittschreiber and Shar Quittschreiber

REGISTERED
PROFESSIONAL
LAND SURVEYOR

Kristina Powell

OREGON
MAY 9, 2017
KRISTINA POWELL
91201

EXPIRES 12-31-22

Office of _____ County Surveyor _____ County of Umatilla
 State of Oregon, I hereby certify that the within instrument was filed in this office
 for record on the _____ day of _____, 20____.
 _____ by _____
 (COUNTY OFFICIAL) (DEPUTY)

22-046-8