

OREGON CORNER RESTORATION FORM

SECTION 28, 29 TOWNSHIP 5 NORTH RANGE 29 EAST
COUNTY : UMATILLA DATE DEC/22

T-9

CORNER DESIGNATION

1/4 CORNER

CONDITION REPORT ONLY

NOT FOUND

RENEWED

UNCOVERED

SURVEYED IN

REFERENCED


PREVIOUS RENEWALS / SURVEYS, ETC.

SURVEYED IN 1861 BY DAVENPORT UNDER CONTRACT #101, HE SET POST AND MADE MOUND.
IN 1979 KRUMBEIN SET A 5/8" IRON ROD.
IN 1979 LAGIER FOUND 5/8" IRON ROD WITH ALUMINUM CAP, SEE SUR. NO. Q-922-B.
IN 1979 LAGIER FOUND 5/8" IRON ROAD WITH ALUMINUM CAP, SEE BK. 12 PG. 16 UMATILLA CO. PLATS. NOT FOUND.

MONUMENTS AND ACCESSORIES FOUND: CONDITION AND SOURCE

FOUND 1 1/2" ALUMINUM STAMPED AS BELOW.
FOUND 5/8" IRON ROD WITH YELLOW PLASTIC CAP STAMPED LS 951 BEARS N 19°13'42" E, 13.69'.
FOUND 5/8" IRON ROD WITH YELLOW PLASTIC CAP STAMPED LS 951 BEARS N 36°28'42" W, 27.18'.
FOUND 5/8" IRON ROD WITH YELLOW PLASTIC CAP STAMPED LS 951 BEARS S 73°44'52" W, 63.86'.
FOUND 5/8" IRON ROD WITH YELLOW PLASTIC CAP STAMPED LS 951 BEARS S 43°04'11" E, 28.46'.

MONUMENT DETAIL

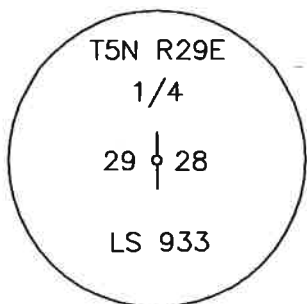

N.T.S

NAD 83/91
OREGON STATE PLANE
INTERNATIONAL FEET

811765.41
8532368.30

MONUMENT SET (PROCEDURES AND DESCRIPTION)

STAMPED "PLS 48509" ON FOUND 1 1/2" ALUMINUM CAP.

NEW ACCESSORIES FROM WHICH

LOCATION AND COMMENTS

CORNER FALLS AT INTERSECTION OF
EDWARDS ROAD AND SPEARMAN
ROAD.

FIRM/AGENCY

PRIMM LAND SURVEYING, INC.
P.O. BOX 1322
HERMISTON, OREGON 97838

LAND SURVEYOR

BRIT L. PRIMM

WITNESS

KEITH P. PRIMM

SURVEYOR'S SEAL

REGISTERED
PROFESSIONAL
LAND SURVEYOR

OREGON
JULY 13, 1999
BRIT L. PRIMM
48509

EXPIRATION DATE: 12/31/24