

OREGON CORNER RESTORATION FORM

SECTION 28, 33 TOWNSHIP 5 NORTH RANGE 29 EAST
COUNTY : UMATILLA DATE DEC/22

V-11

CORNER DESIGNATION

1/4 CORNER

- CONDITION REPORT ONLY
- NOT FOUND
- RENEWED
- UNCOVERED
- SURVEYED IN
- REFERENCED


PREVIOUS RENEWALS / SURVEYS, ETC.

SURVEYED IN 1861 BY DAVENPORT UNDER CONTRACT #101, HE SET POST AND MADE MOUND.
IN 1913 KIMBRELL SET A 3" IRON PIPE.
IN 1990 LS 951 SET A 2 1/2" BRASS DISK IN CONCRETE OVER 3" IRON PIPE.

MONUMENTS AND ACCESSORIES FOUND: CONDITION AND SOURCE

FOUND 2 1/2" BRASS DISK STAMPED AS BELOW.
FOUND 5/8" IRON ROD WITH PLASTIC CAP STAMPED LS 951 BEARS N 44°45'43" W, 30.43'.
FOUND 5/8" IRON ROD WITH PLASTIC CAP STAMPED LS 951 BEARS S 76°31'53" E, 76.05'.
FOUND ALUMINUM TAG IN RAIL ROAD TIE STAMPED LS 951 BEARS S 58°03'14" W, 50.54'.

MONUMENT DETAIL

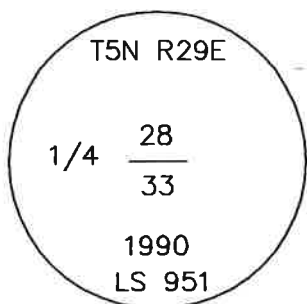

N.T.S

NAD 83/91
OREGON STATE PLANE
INTERNATIONAL FEET

809191.84
8535059.11

MONUMENT SET (PROCEDURES AND DESCRIPTION)

NEW ACCESSORIES FROM WHICH

SET 5/8" X 30" IRON ROD WITH YELLOW PLASTIC CAP STAMPED PLS LS 48509 BEARS N 43°02'45" E, 34.34'.

LOCATION AND COMMENTS

CORNER FALLS AT INTERSECTION OF
WALLS ROAD AND GOLDA ROAD.

FIRM/AGENCY

PRIMM LAND SURVEYING, INC.
P.O. BOX 1322
HERMISTON, OREGON 97838

LAND SURVEYOR

BRIT L. PRIMM

WITNESS

KEITH P. PRIMM

SURVEYOR'S SEAL

REGISTERED
PROFESSIONAL
LAND SURVEYOR

OREGON
JULY 13, 1999
BRIT L. PRIMM
48509

EXPIRATION DATE: 12/31/24