

OREGON CORNER RESTORATION FORM

SECTION 25, 26, 35, 36 TOWNSHIP 5 NORTH RANGE 29 EAST
COUNTY : UMATILLA DATE DEC/22

V-21

CORNER DESIGNATION
SECTION CORNER

CONDITION REPORT ONLY
 NOT FOUND
 RENEWED
 UNCOVERED
 SURVEYED IN
 REFERENCED


PREVIOUS RENEWALS / SURVEYS, ETC.

SURVEYED IN 1861 BY DAVENPORT UNDER CONTRACT #101, HE SET POST AND MADE MOUND.
IN 1975 KRUMBEIN SET A 1" X 30" IRON PIPE
IN 2000 WELLS SET A 2 1/2" BRASS CAP.

MONUMENTS AND ACCESSORIES FOUND: CONDITION AND SOURCE

FOUND 2 1/2" BRASS CAP STAMPED AS BELOW.
FOUND 5/8" IRON ROD WITH PLASTIC CAP STAMPED LS 1106 BEARS N 82°22'41" E, 91.47'.
FOUND 5/8" IRON ROD WITH PLASTIC CAP STAMPED LS 1106 BEARS S 00°12'39" E, 9.21'.
FOUND 5/8" IRON ROD WITH PLASTIC CAP STAMPED LS 1106 BEARS S 00°12'39" E, 70.26'.
FOUND 5/8" IRON ROD WITH PLASTIC CAP STAMPED LS 1106 BEARS S 77°54'50" W, 131.47'.

MONUMENT DETAIL

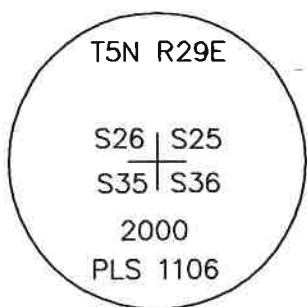

NAD 83/91
OREGON STATE PLANE
INTERNATIONAL FEET

809413.34
8548253.59

MONUMENT SET (PROCEDURES AND DESCRIPTION)

NEW ACCESSORIES FROM WHICH

LOCATION AND COMMENTS

FROM EAST-WEST WALLS ROAD TO
WHERE WALLS ROAD ANGLES AND
GOES NORTHEAST. CORNER FALLS
NORTH +/- 15 FEET.

FIRM/AGENCY

PRIMM LAND SURVEYING, INC.
P.O. BOX 1322
HERMISTON, OREGON 97838

LAND SURVEYOR

BRIT L. PRIMM

WITNESS

KEITH P. PRIMM

SURVEYOR'S SEAL

REGISTERED
PROFESSIONAL
LAND SURVEYOR

Brit L. Primm
OREGON
JULY 13, 1999
BRIT L. PRIMM
48509

EXPIRATION DATE: 12/31/24