

OREGON CORNER RESTORATION FORM

SECTION 31, 36 TOWNSHIP 5 NORTH RANGE 29 EAST, RANGE 30 EAST
COUNTY : UMATILLA DATE DEC/22

X-25

CORNER DESIGNATION
1/4 CORNER

CONDITION REPORT ONLY
 NOT FOUND
 RENEWED
 UNCOVERED
 SURVEYED IN
 REFERENCED


PREVIOUS RENEWALS / SURVEYS, ETC.

SURVEYED IN 1861 BY PAYNE UNDER CONTRACT #100, HE SET A POST AND MADE MOUND.
IN 2005 LS 951 SET A 2 3/8" BRASS CAP.

MONUMENTS AND ACCESSORIES FOUND: CONDITION AND SOURCE

FOUND 1" IRON PIPE IN CONCRETE BENT AND LEANING WEST.
FOUND 5/8" IRON ROD WITH YELLOW PLASTIC CAP STAMPED LS 951 BEARS S 00°26'28" W, 11.44'.
FOUND 5/8" IRON ROD WITH YELLOW PLASTIC CAP STAMPED LS 951 BEARS S 55°31'58" E, 19.45'.

MONUMENT DETAIL

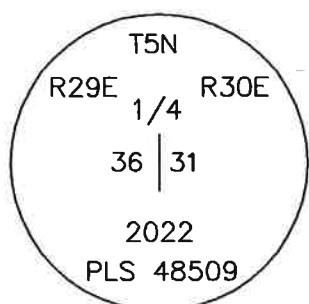

NAD 83/91
OREGON STATE PLANE
INTERNATIONAL FEET

806825.30
8553592.26

MONUMENT SET (PROCEDURES AND DESCRIPTION)

SET 5/8" X 4" IRON ROD (DRILLED IN CONCRETE AT LOCATION OF FOUND 1" IRON PIPE) WITH 2" ALUMINUM CAP STAMPED AS ABOVE.

NEW ACCESSORIES FROM WHICH

SET 5/8" X 30" IRON ROD WITH YELLOW PLASTIC CAP STAMPED PLS LS 48509 BEARS S 71°49'50" W, 37.64'.
SET 5/8" X 30" IRON ROD WITH YELLOW PLASTIC CAP STAMPED PLS LS 48509 BEARS S 77°58'21" E, 46.94'.

LOCATION AND COMMENTS

FROM THE POINT OF INTERSECTION OF A CURVE WHERE HIGHLAND EXTENSION TO COLD SPRINGS ROAD TURNS EAST, GO NORTH +/- 0.5 MILE TO CORNER. CORNER FALLS ON SOUTHERLY EDGE OF CROP CIRCLE.

FIRM/AGENCY

PRIMM LAND SURVEYING, INC.
P.O. BOX 1322
HERMISTON, OREGON 97838

LAND SURVEYOR

BRIT L. PRIMM

WITNESS

KEITH P. PRIMM

SURVEYOR'S SEAL

REGISTERED
PROFESSIONAL
LAND SURVEYOR

Brit L. Primm
OREGON
JULY 13, 1999
BRIT L. PRIMM
48509

EXPIRATION DATE: 12/31/24