

OREGON CORNER RESTORATION FORM

SECTION 31, 32 TOWNSHIP 5 NORTH RANGE 29 EAST
COUNTY : UMATILLA DATE DEC/22

X-5

CORNER DESIGNATION

1/4 CORNER

- CONDITION REPORT ONLY
- NOT FOUND
- RENEWED
- UNCOVERED
- SURVEYED IN
- REFERENCED


PREVIOUS RENEWALS / SURVEYS, ETC.

SURVEYED IN 1861 BY DAVENPORT UNDER CONTRACT #101, HE SET POST AND MADE MOUND.
IN 1977 SHEA SET A RAIL ROAD SPIKE.
IN 1984 LS 951 SET A 1/2" IRON ROD.

MONUMENTS AND ACCESSORIES FOUND: CONDITION AND SOURCE

FOUND 1/2" IRON ROD.
FOUND 5/8" IRON ROD WITH YELLOW PLASTIC CAP STAMPED LS 951 BEARS N 25°31'18" W, 26.36'.
FOUND 5/8" IRON ROD WITH YELLOW PLASTIC CAP STAMPED LS 951 BEARS S 78°55'09" W, 134.42'.
FOUND 5/8" IRON ROD WITH YELLOW PLASTIC CAP STAMPED LS 951 BEARS S 47°49'05" W, 42.28'.
FOUND 5/8" IRON ROD WITH YELLOW PLASTIC CAP STAMPED LS 951 BEARS S 20°27'19" E, 62.80'.

MONUMENT DETAIL

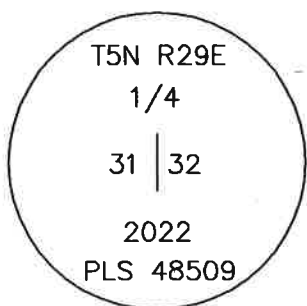

NAD 83/91
OREGON STATE PLANE
INTERNATIONAL FEET

806462.46
8527138.96

MONUMENT SET (PROCEDURES AND DESCRIPTION)

SET 5/8" X 30" IRON ROD (AT LOCATION OF FOUND 1/2" IRON ROD) WITH 2" ALUMINUM CAP STAMPED AS ABOVE.

NEW ACCESSORIES FROM WHICH

LOCATION AND COMMENTS

CORNER FALLS AT INTERSECTION OF
CRAIG ROAD AND BEASON LANE
(WEST COLUMBIA LANE).

FIRM/AGENCY

PRIMM LAND SURVEYING, INC.
P.O. BOX 1322
HERMISTON, OREGON 97838

LAND SURVEYOR

BRIT L. PRIMM

WITNESS

KEITH P. PRIMM

SURVEYOR'S SEAL

REGISTERED
PROFESSIONAL
LAND SURVEYOR

OREGON
JULY 13, 1999
BRIT L. PRIMM
48509

EXPIRATION DATE: 12/31/24