

**OREGON CORNER RESTORATION FORM**

COUNTY: Umatilla. DATE: 12/08/23.

CORNER DESIGNATION: R-19, the North one-quarter corner of Section 26, Township 5 North, Range 33 East, W.M.

PREVIOUS RENEWALS/SURVEYS ETC: Corner was originally established by Odell and Lewis, Deputy Surveyors under Contract No. 110, dated February 7, 1865. Original notes state: "Set 1/4 Sec Post. Drove charred stake. Dug pits and raised mound as per instructions". This 1/4 corner is the point of beginning for old Duroc County Road No. 410, (now Road 821D), is an angle point in old County Road No. 253, (now Road 821), which formerly extended East from the 1/4 corner, and is the point of beginning for old County Road No. 328, (now Road 802). It appears the centerline of present County Road 802 is South of the original location at the 1/4 corner.

MONUMENT AND ACCESSORIES FOUND: None. I held the intersection of a field line extending East and the Southerly projection of the centerline of Duroc Road, North-South as best remaining evidence of the original corner location. Consulted and studied 1956 and 1980 aerial photography and County Road notes and plats to confirm corner position.

**MONUMENT MARKING DETAIL:**

T5N R33E
S23
1/4 -----
S26
2023
PLS 1106

**NEW CORNER MONUMENT SET:** At the reestablished corner position, set a 2 1/2 inch brass cap on 1 1/4 by 30 inch galvanized iron pipe, with brass cap 7 inches below road surface. Placed a "witness" sign below ground on top of the corner monument. The brass cap is marked as shown in "Monument Marking Detail".

**New accessories set:**

- A 5/8 by 24 inch rebar with fed plastic cap marked "OR PLS 1106 WA PLS 17372, 4 feet East of the East edge of Duroc Road bears N 31°42'47" East, 31.80 feet, with bearing object sign wired to it.
- A 5/8 by 24 inch rebar with red plastic cap marked "OR PLS 1106 WA PLS 17372, 4 feet South of Road Sign bears S 34°09'30" West, 62.57 feet, with bearing object sign wired to it.
- A 5/8 by 24 inch rebar with red plastic cap marked "OR PLS 1106 WA PLS 17372, 4 feet South of phone pedestal, bears S 54°03'36" West, 68.30 feet, with bearing object sign wired to it.
- A 5/8 by 24 inch rebar with red plastic cap marked "OR PLS 1106 WA PLS 17372, 8 feet West of the West edge of Duroc Road bears N 36°15'17" West, 51.33 feet, with bearing object sign wired to it.

Bearings to corner accessories are State Plane Grid bearings and distances.


**LOCATION AND COMMENTS:** Corner Monument falls in a road intersection at the Westerly projection of an East-West field line. Map reference: Partition Plat No. 2023-19.

**OREGON STATE PLANE COORDINATE,** North Zone NAD 83(2011) epoch 2010.00, International Feet Units:


N: 816693.49  
E: 8672695.96

FIRM: Wells Surveying  
P.O. Box 1696  
Pendleton, OR 97801

Surveyor's Seal

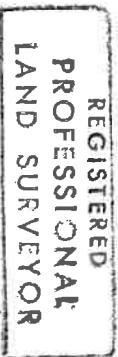

*William R. Wells*

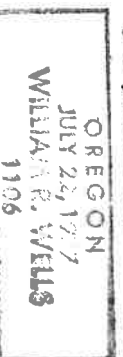

Renews: 6-30-24

15N33R-19

24-009-R