

OREGON CORNER RESTORATION FORM

Section 36 Township 6N Range 33E
 County Umatilla Date: April 1, 2003

Corner Designation: 6N33Z25

Corner to section 36, T6N, R33E, section 31, T6N, R34E, section 1, T5N, R33E, and section 6, T5N, R34E, W.M., Umatilla County, Oregon.

Condition Report Only
 Not found
 Remonumented
 Unrecorded
 Surveyed in
 Referenced out



State Plane Coordinates, Oregon North, 83(1991) based on a single GPS tie to Tri Station GEER. N = 836657.62 E = 8679944.01

Previous Renewals / Surveys, etc.

Corner originally set by Deputy Surveyors Odell & Lewis under contract No. 110 dated February 7th, 1865. Their record reads: Set post Cor., for Tps. 5 & 6 N, Rs. 33 & 34 E. & Secs. 1, 6, 31 & 36. Drove Charred stake; dug pits & raised mound, as per instructions. John Kimbrell set a stone stone 20 x 10 x 8 inches" by three way proportioning from the west, east and north. I set a brass cap at the position of Kimbrell's stone in County Survey 03-21-C in December of 2002.

Monument and Accessories found: (condition and source)

The brass cap I set in 2002 and a fence corner which agrees with the bearings and distances of U.S. Deputy Surveyor Nicholas Walden who retraced the Odell & Lewis Work.

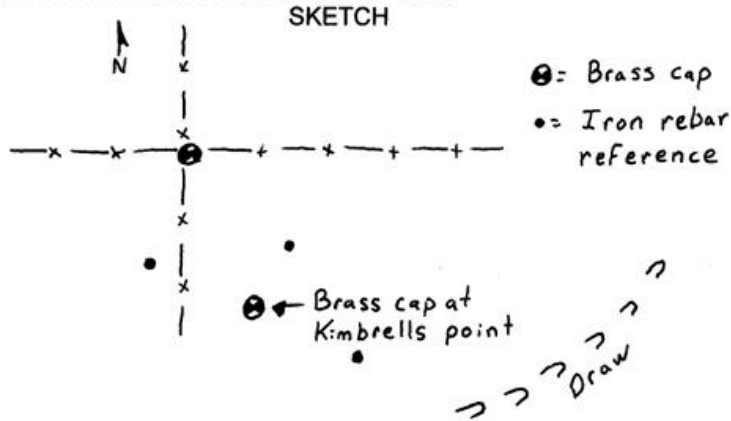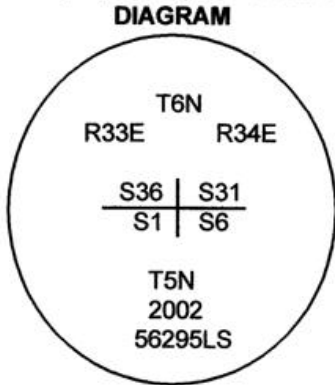

Monument and Accessories set:

Since the December survey I have done extensive retracement of work by U.S. Deputy Surveyor Nicholas Walden and have found his work reliable. I set a 2 1/4" brass cap on a 30" galvanized pipe stamped as shown in the diagram above at the fence intersection which has evidence of being the long term possessory location. I set a 5' steel guard post with a county monument sign attached along side and remarked the previous brass cap I set with the letters W. C..

For references, I used the monuments I set in December. The brass cap bears:

S10°03'29"E, 98.73 feet;

I held 3, 5/8" x 24" green coated iron rebars with orange plastic caps stamped WTS and 56295LS as described below.

a rebar bears S23°16'13"E, 74.81 feet;

a rebar bears S05°08'41"W, 80.01 feet;

a rebar bears S33°14'17"E, 141.56 feet;

The monument and references were tied using a LIECA system 300 RTK GPS.

Location and comments

Compass Declination

Surveyors Seal

RECEIVED BY:

Umatilla County Surveyor

Date: 11-03

Rec'd By: KF

No. 03-315-c

Firm / Agency
 Witness Tree Surveying
 Address
 P.O. Box G
 Pilot Rock, Or. 97868
 Party Chief
 Stephen K, Haddock

REGISTERED
 PROFESSIONAL
 LAND SURVEYOR

Stephen K. Haddock

OREGON
 JULY 9, 2001
 STEPHEN K. HADDOCK
 56295LS

RENEWAL DATE 6-30-05