

OREGON CORNER RESTORATION FORM

Section 11 Township 5N Range 34E
 County Umatilla Date: April 7, 2003

Condition Report Only
 Not found
 Remonumented
 Unrecorded
 Surveyed in
 Referenced out

Corner Designation: 5N34E17



Corner to sections 2, 3, 10, and 11, T5N, R34E,
 W.M., Umatilla County, Oregon.

State Plane Coordinates, Oregon North, 83(1991) from a
 single GPS tie to Tri Station GEER, N = 832362.95 E = 8701159.00

Previous Renewals / Surveys, etc.

Corner originally set by Wm. H. Odell & Wm. S. Lewis under contract No. 110 dated February 7th, 1865. Their record reads: Set post Cor. for Secs. 2, 3, 10, & 11. Drove Charred Stake; dug pits and raised mound, as per instructions. John Kimbrell in the survey in Book 1, Page 400 of the record of private surveys said "could find no trace of corner. Set stone 16 x 12 x 8. Willard Bradley in the survey in Book 2, Page 276 of the record of private surveys says "found a set stone on top of ridge".

Monument and Accessories found: (condition and source)
 A basalt stone 15" x 12" x 9" marked "x" on top set firmly in the ground.

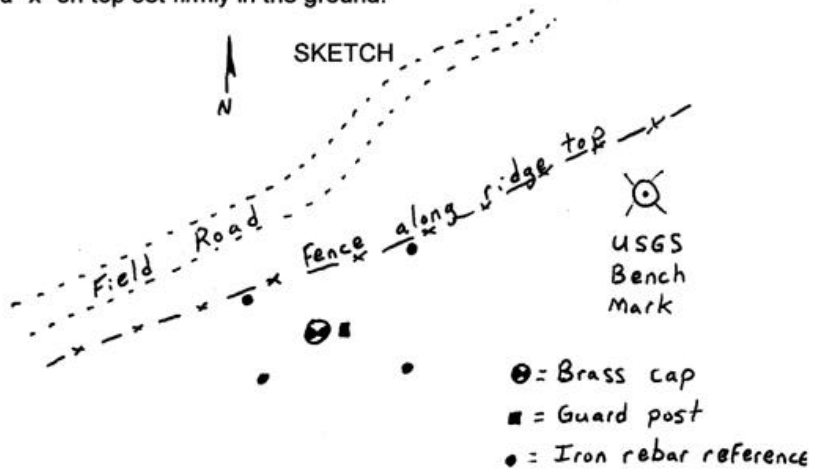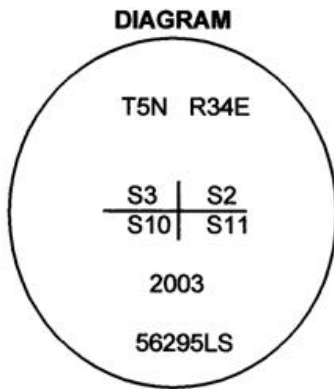

MONUMENT (S) AND ACCESSORIES SET (Procedures and Description)

I set a 1 1/2" x 30" galvanized iron pipe with a 2 1/4" brass cap stamped as shown in the diagram above at the position of the stone. I set a 5' steel guard post with a County Monument sign along side. I buried the stone along side.

For references, I set four, 5/8" by 24" green coated iron rebars with 1.25" orange plastic caps stamped WTS and 56295LS as described below:
 a rebar bears N19°30'40"W, 18.24 feet;
 a rebar bears S55°50'36"W, 48.62 feet;
 a rebar bears N61°50'14"E, 26.95 feet;
 a rebar bears S40°54'56"E, 23.89 feet;
 an unpublished standard USGS brass disc bears N38°09'11"E, 535.08' on top of a small knoll.

The monument and references were tied using a LIECA system 300 RTK GPS.

Location and comments

Compass Declination

Surveyors Seal

RECEIVED BY:
Umatilla County Surveyor
 Date: 10-03
 Rec'd By: KK
 No. 03-314-C

Firm / Agency
 Witness Tree Surveying
 Address
 P.O. Box G
 Pilot Rock, Or. 97868
 Party Chief
 Stephen K, Haddock

REGISTERED PROFESSIONAL LAND SURVEYOR
Stephen K. Haddock
 OREGON
 JULY 9, 2001
 STEPHEN K. HADDOCK
 56295LS
 RENEWAL DATE 6-30-05