

OREGON CORNER RESTORATION FORM

Section 9 Township 5N Range 36E
 County Umatilla Date: August 16, 2012

Corner Designation: 5N36J11

Quarter corner common to sections 9 and 16,
 T5N, R36E, W.M., Umatilla County, Oregon.


Condition Report Only
 Not found
 Remonumented
 Unrecorded
 Surveyed in
 Referenced out

Previous Renewals / Surveys, etc.

Corner originally set by Odell and Lewis under contract No. 110 dated February 7, 1865. Their record reads: Set 1/4 Sec. post, drove charred stake, dug pits and raised mound, as per instructions. In the record of private surveys Book 1, Page 404, John Kimbrell reports: set stone 14x8x6 for 1/4 sec. corner.

Monument and Accessories found: (condition and source)
 The intersection of fence lines east and west and a field line north.


DIAGRAM

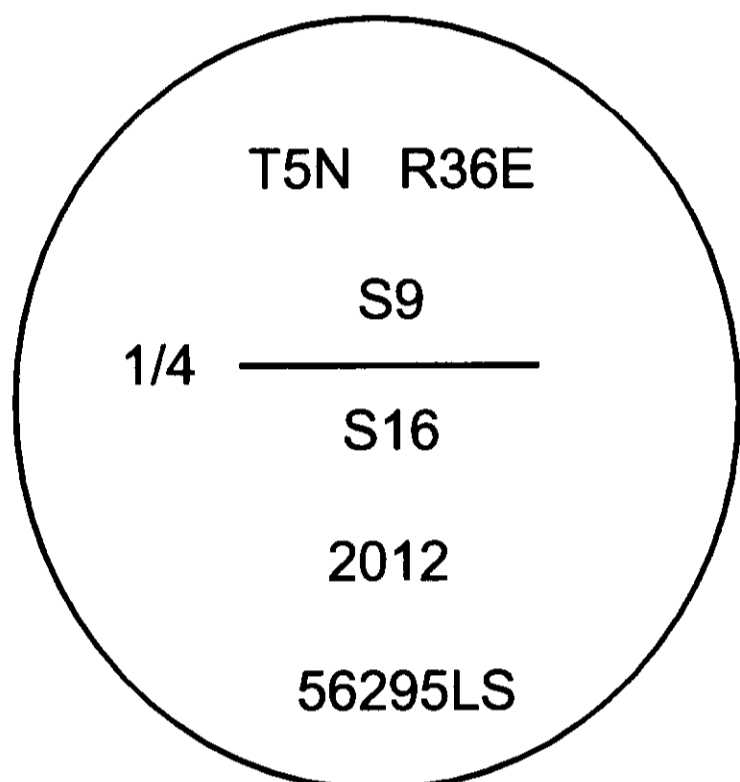

⊗ = Brass Cap

● = Rebar Reference

SKETCH

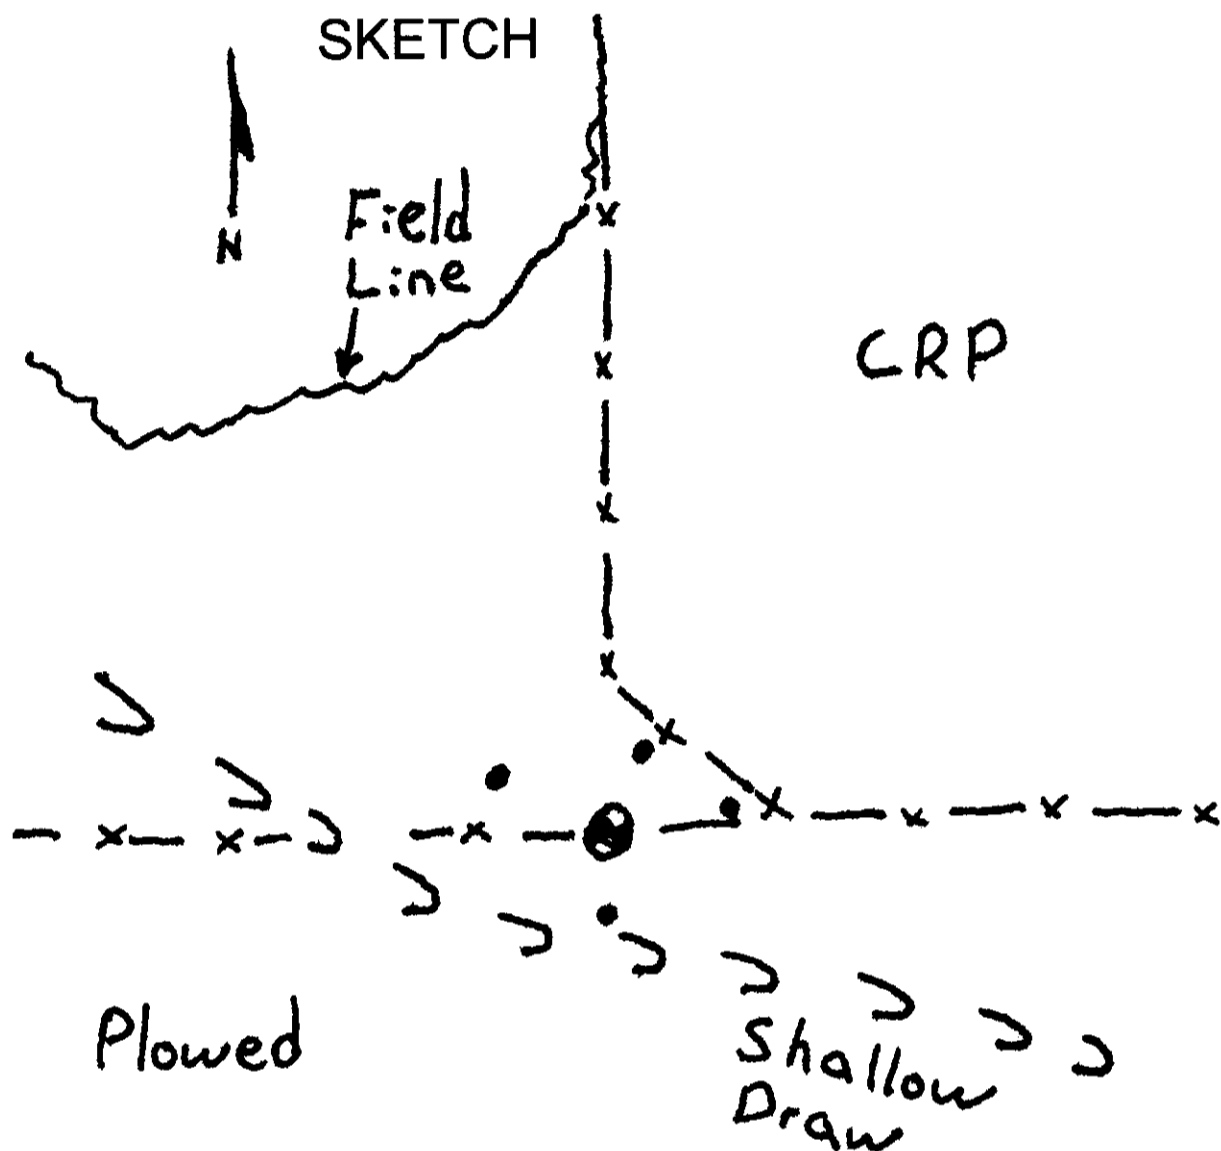

MONUMENT (S) AND ACCESSORIES SET (Procedures and Description)

At the position of the intersection described above, I set a 2 3/8" brass cap on a 1 1/2" x 30" galvanized iron pipe stamped as shown in the diagram above.

For references, I set four 5/8" by 24" iron rebars with 1 1/4" orange plastic caps stamped WTS and 56295LS as described below:

- an iron rebar bears N72°46'43"W, 31.88 feet;
- an iron rebar bears N38°54'00"E, 29.09 feet;
- an iron rebar bears S84°48'11"E, 40.78 feet;
- an iron rebar bears S3°20'42"W, 17.78 feet;

The monument and references were tied using a Trimble R7/R8 RTK GPS system.

Location and comments
 NAD 83/1991 State Plane Coordinate
 Oregon North Zone
 N = 82836126 ift
 E = 8757060.71 ift

Compass Declination

Surveyors Seal

RECEIVED BY:
 Umatilla County Surveyor
 Date: 12/6/2012
 Rec'd By: S. Pres
 No. 12-155-B

Firm / Agency
 Witness Tree Surveying
 Address
 P.O. Box G
 Pilot Rock, Or. 97868
 Party Chief
 Stephen K, Haddock

REGISTERED
 PROFESSIONAL
 LAND SURVEYOR

Stephen K. Haddock

OREGON
 JULY 9, 2001
 STEPHEN K. HADDOCK
 56295LS

RENEWAL DATE 6-30-13