

OREGON CORNER RESTORATION FORM

Section 18 Township 5N Range 36E
 County Umatilla Date: September 17, 2012

Corner Designation: 5N36N3

Quarter corner common to sections 18 and 19,
 T5N, R36E, W.M., Umatilla County, Oregon.


Condition Report Only
 Not found
 Remonumented
 Unrecorded
 Surveyed in
 Referenced out

Previous Renewals / Surveys, etc.

Corner originally set by Odell and Lewis under contract No. 110 dated February 7, 1865. Their record reads: Set 1/4 Sec. post, drove charred stake, dug pits and raised mound, as per instructions. In survey Q-1337-C, F.B. Hayes says: Re-established pipe.


Monument and Accessories found: (condition and source)
 A 3/4" iron pipe set flush with the surface.

DIAGRAM

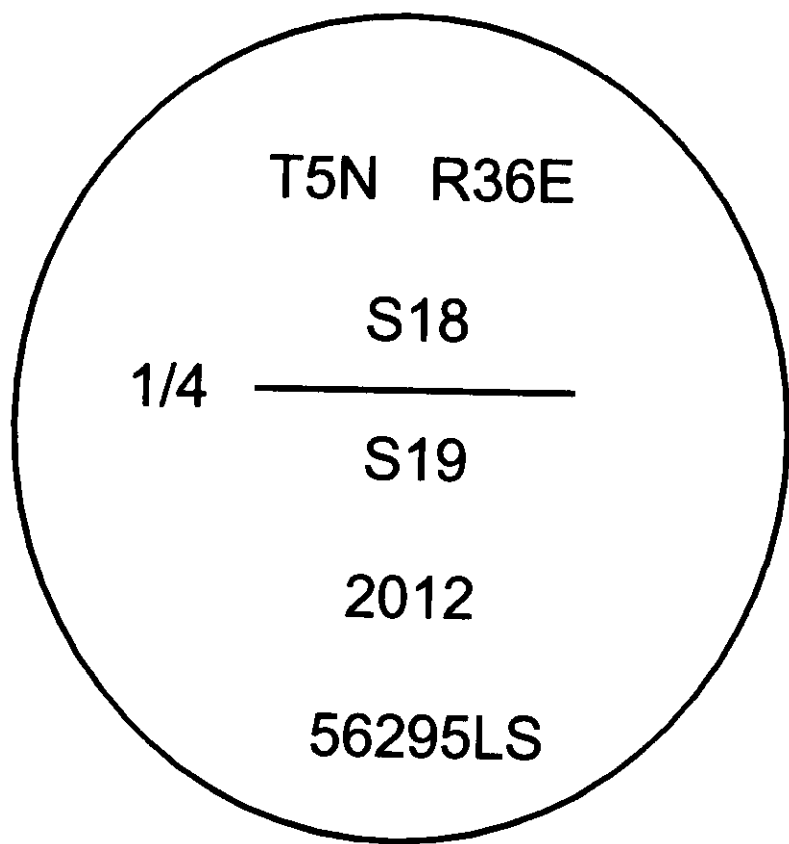

⊗ = Brass Cap
 ● = Rebar Reference

SKETCH

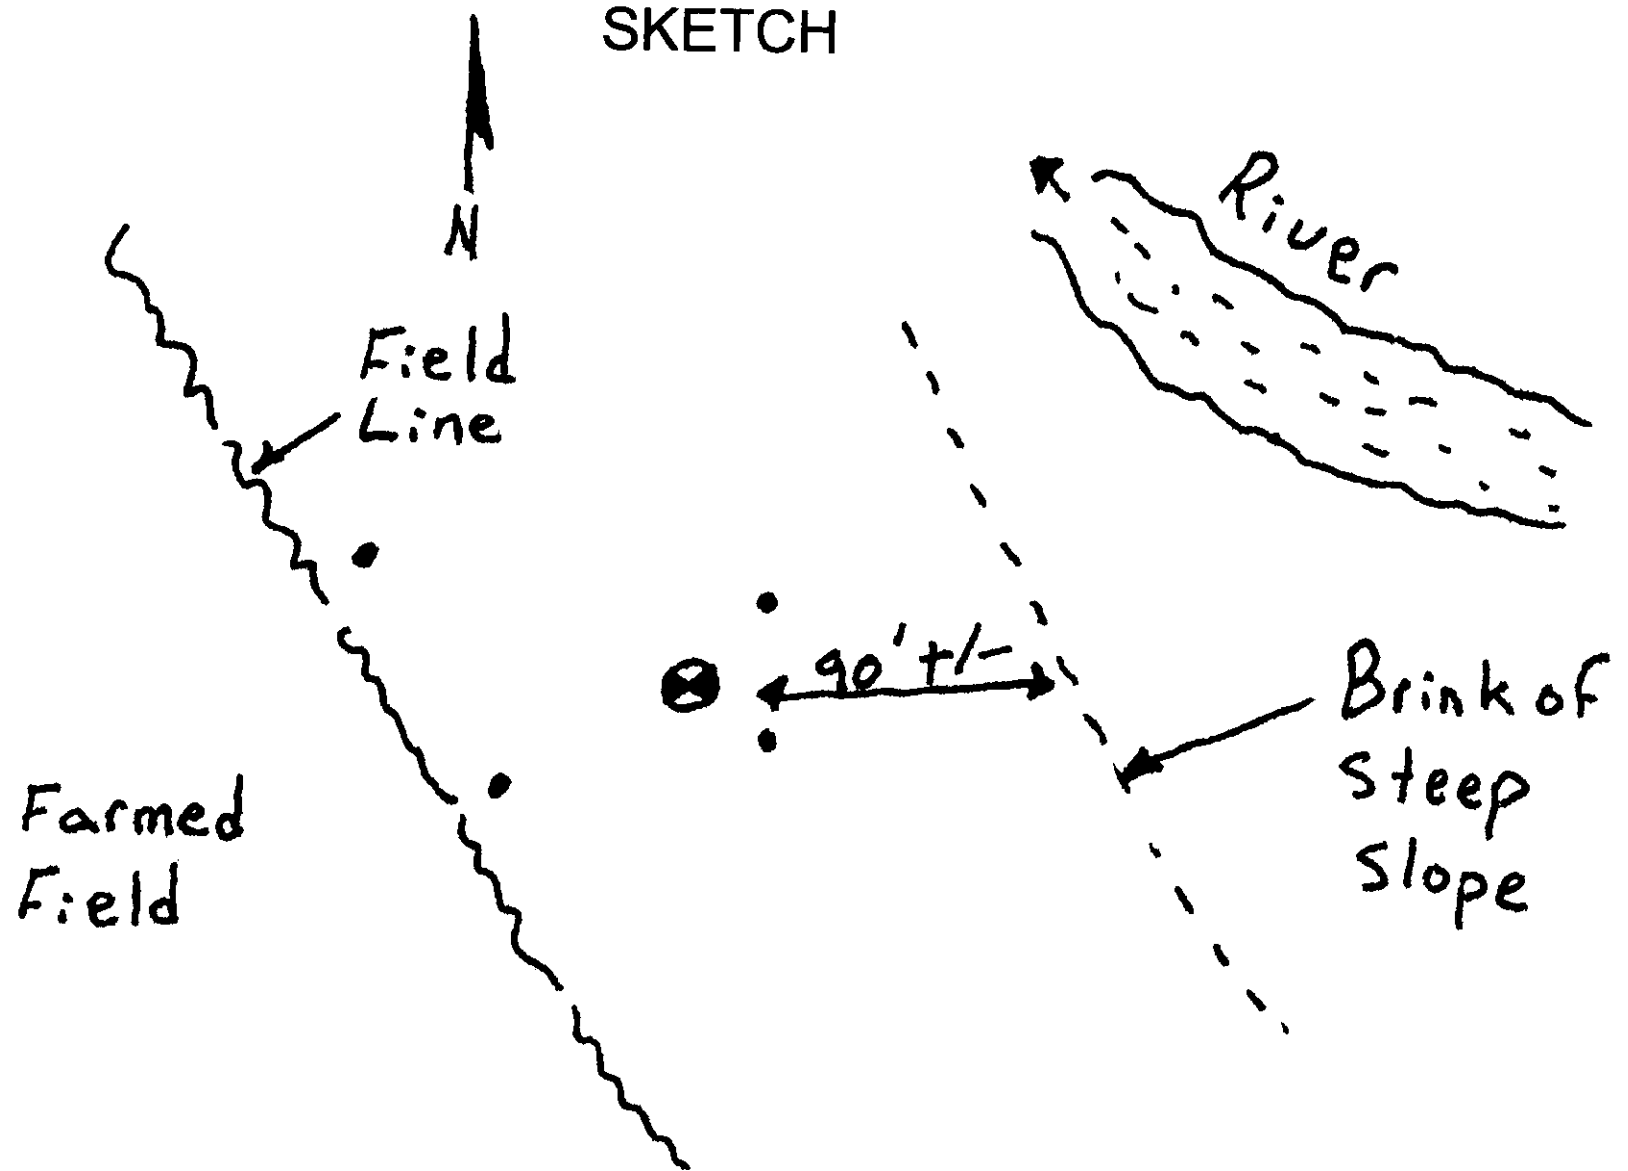

MONUMENT (S) AND ACCESSORIES SET (Procedures and Description)

Over the 3/4" iron pipe, I set a 2 3/8" brass cap on a 1 1/2" x 30" galvanized iron pipe stamped as shown in the diagram above flush with the surface of the ground.

For references, I set four 5/8" by 24" iron rebars with 1 1/4" orange plastic caps stamped WTS and 56295LS as described below:

- an iron rebar bears N63°55'05"W, 57.73 feet;
- an iron rebar bears N22°09'56"E, 25.10 feet;
- an iron rebar bears S62°02'40"E, 24.95 feet;
- an iron rebar bears S39°09'21"W, 41.45 feet;

The monument and references were tied using a Trimble R7/R8 RTK GPS system.

Location and comments
 NAD 83/1991 State Plane Coordinate
 Oregon North Zone
 N = 822505.26 ift
 E = 8746385.13 ift

Compass Declination

Surveyors Seal

Firm / Agency
 Witness Tree Surveying
 Address
 P.O. Box G
 Pilot Rock, Or. 97868
 Party Chief
 Stephen K, Haddock

REGISTERED
 PROFESSIONAL
 LAND SURVEYOR

Stephen K. Haddock

OREGON
 JULY 9, 2001
 STEPHEN K. HADDOCK
 56295LS

RENEWAL DATE 6-30-13

RECEIVED BY:
 Umatilla County Surveyor
 Date: 12/6/2012
 Rec'd By: J. Oles
 No. 12-155-1B