

CERTIFIED RECORD OF LAND CORNER MONUMENTATION
Center one-quarter Section 12,
Umatilla County, Oregon.


History of original corner establishment:

None!

9-23

Description of evidence found:

Found evidence of a fence corner at an intersection of an ancient fence bearing northerly into this corner and another ancient fence bearing easterly out of this corner. A row of trees some 90+ years old straddles the northerly bearing fence.

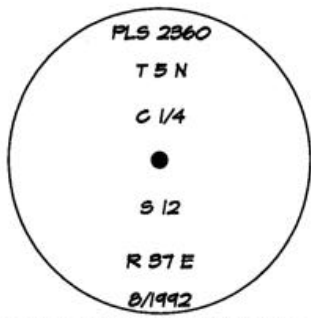

Description of monument and accessories I established to perpetuate the original location of this corner:

I set a 1" standard "Hoffland" galvanized iron pipe with 2-1/2" Bronze cap marked as shown, flush with the surface of the ground, from which:
A 20 in. dia. Douglas Fir bears N9°30'W, a distance of 26.96 feet to center, with face mkd. "C1/4S12BT".
An Aluminum nail is driven into a 3/4 in. Brass washer mkd. "PLS 2360" in the center of the "B" marked on the face which is typical for all bearing trees marked at this position.

A 19 in. dia. Engelmann Spruce bears N27°E, a distance of 26.50 feet to center, with face mkd. "C1/4S12BT".

A 17-1/2 in. dia. Douglas Fir bears S68°E, a distance of 14.84 feet to center, with face mkd. "C1/4S12BT".

An 11-1/2 in. dia. Engelmann Spruce bears S60°30'W, a distance of 22.50 feet to center, with face mkd. "C1/4S12BT".

I affixed Umatilla County Surveyor Yellow Metal Bearing Object signs to these Bearing Trees. I also affixed Bearing Tree signs (penalty for disturbance, etc.) to each tree.

Bearings are magnetic using a "Silva Ranger" compass, with a declination of 19°E, calibrated to true bearing from Solar observations.

REGISTERED
PROFESSIONAL
LAND SURVEYOR

Paul W.P. Tomkins

OREGON
JULY 26, 1988
PAUL W.P. TOMKINS
2360

8/26/92

Office of _____ County of _____
State of _____, I hereby certify that the within instrument was
filed in this office for record on the _____ day of _____, 19____
_____ by _____
(COUNTY OFFICIAL) (DEPUTY)

RECEIVED BY
Umatilla County Surveyor
Date 9-92
Rec'd By KK
No. 92-106-C