

OREGON CORNER RESTORATION FORM

Section 13 Township 5N Range 36E
 County Umatilla Date: May 12, 2012

Corner Designation: 5N36J25

Corner common to sections 12, 13, R36E and sections 7 and 18 of R37E, T5N, W.M., Umatilla County, Oregon.


Condition Report Only
 Not found
 Remonumented
 Unrecorded
 Surveyed in
 Referenced out

Previous Renewals / Surveys, etc.

Corner was originally set by Odell and Lewis under contract No. 110 dated February 7, 1865. Their record reads: Set post cor. for Secs. 12, 13, 7 & 18, drove charred stake, dug pits and raised mound, as per instructions. John Kimbrell in the Record of Private Surveys Book 1, page 374 (Survey 99) states "found original corner".


Monument and Accessories found: (condition and source)
 None. The point falls in a farmed field near an erosion control ditch.

DIAGRAM

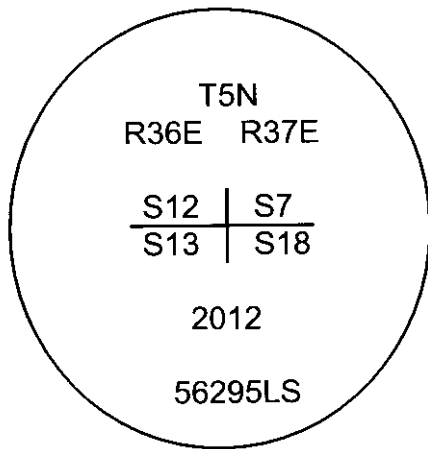

⊗ = Brass cap.
 • = Rebar reference.

SKETCH

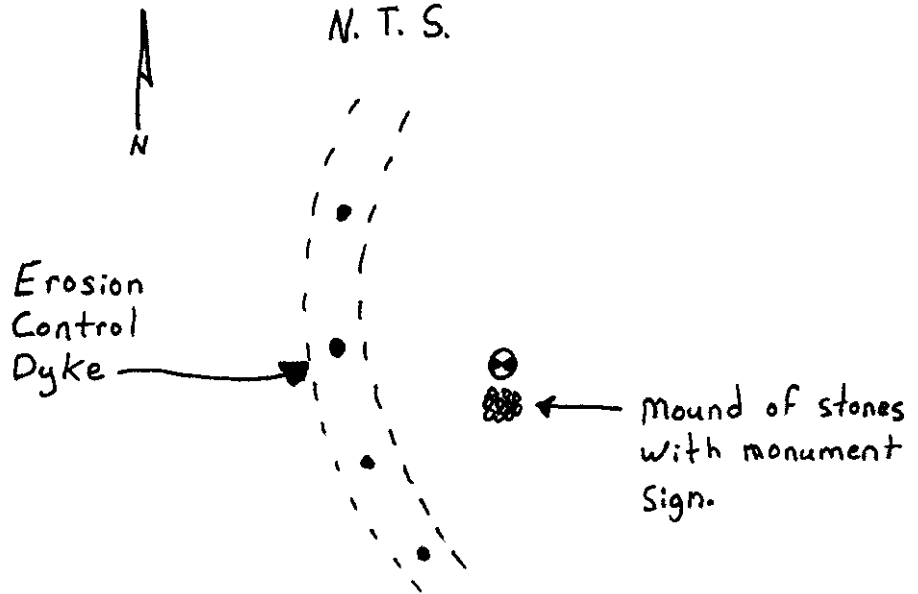

MONUMENT (S) AND ACCESSORIES SET (Procedures and Description)

I set a 2 3/8" brass cap on a 1 1/2"x30" galvanized iron pipe with a brass cap stamped as shown in the diagram above 28" in the ground to bedrock at the proportionate point.

For references: I set 4, 5/8"x24" iron rebars with orange plastic caps stamped WTS and 56295LS as described below 2 feet below the surface of the outer bank of the erosion ditch.

- An iron rebar bears S20°57'47"W, 74.09 feet;
- An iron rebar bears S57°16'16"W, 67.42 feet;
- An iron rebar bears N88°09'17"W, 73.95 feet;
- An iron rebar bears N54°22'21"W, 105.91 feet;

The monument and references were tied using a Trimble R7/R8 RTK GPS system.


Location and comments
 NAD 83/1991 State Plane Coordinate
 Oregon North Zone
 N = 829202.49 ift
 E = 8775281.23 ift

Compass Declination


Surveyors Seal

RECEIVED BY:
Umatilla County Surveyor
 Date: 6/5/2012
 Rec'd By: S. Rice
 No. 12-088-C

Firm / Agency
 Witness Tree Surveying
 Address
 P.O. Box G
 Pilot Rock, Or. 97868
 Party Chief
 Stephen K, Haddock

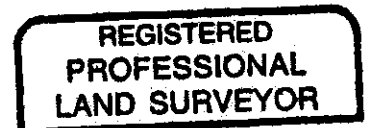

Stephen K. Haddock

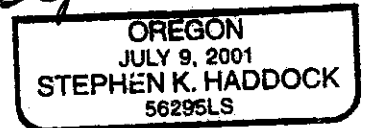

RENEWAL DATE 6-30-13