

USDA-FOREST SERVICE

Index File No. B-11

CORNER RECORD (SEARCH)
(Ref. FSM 7151.4)

Tract or Survey No. _____ Cor. No. _____

T 5N R. 38E


R.D. W² County UMATILLA

Merid. WILL

N.F. UMATILLA State OREGON

CORNER DIAGRAM

DESCRIBE CORNER MONUMENT FOUND

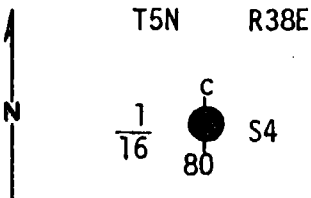

DESCRIBE BEARING TREES OR OTHER OFFICIAL ACCESSORIES FOUND

Description of monument and accessories established to perpetuate the original location of this corner: At surveyed point 1"x30" galvanized pipe with 3" brass cap stamped:

Set pipe 20" in ground with mound of stone to cap.


Bearing trees:

A Spruce 5" dia bears N45°E 28.4 ft scribed C1/16 80 S4 BT.

A Spruce 8" dia bears N74°W 57.8 ft scribed C1/16 80 S4 BT.

Attached 54-3 & 54-4 signs to both BT's. Attached brass washer stamped LS 1294 to foot blaze of both BT's. Painted blazes and 6" band around both BT's red.

CROWN ZELLERBACH
T5N R38E

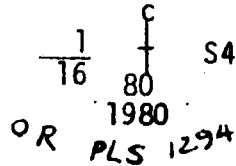

Agency _____ Title _____ Division _____ Headquarters _____ Date 9/80 7100-52 (3.68)

Signature HOWARD L. PERRY Title PLS 1294

CORNER RECORD (PERPETUATION)

MONUMENT : DESCRIBE NEW MONUMENT SET, OR WORK DONE TO PRESERVE EXISTING MONUMENT

ACCESSORIES : DESCRIBE NEW BY'S WITNESS OBJECTS ETC. ESTABLISHED, OR WORK DONE TO PRESERVE EXISTING EVIDENCE

Work Done By _____ Title _____ Date _____ State Registration No. _____
or Agency _____

Certified Cor. Record Prepared ? Yes No Filed At: _____ Date _____

REMARKS

Index File No. T. R. M. Tract or Surv. No. Cor.

B-11

5N

38E