

USDA-FOREST SERVICE

Index File No. C-13

CORNER RECORD (SEARCH)
(Ref. FSM 7151.4)


Tract or Survey No. _____ Cor. No. _____

T 5N R. 38E R.D. W² County UMATILLA

Merid. WILL N.F. UMATILLA State OREGON

CORNER DIAGRAM

DESCRIBE CORNER MONUMENT FOUND

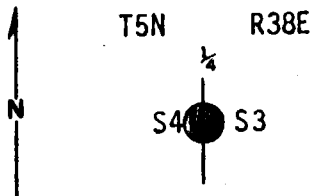

DESCRIBE BEARING TREES OR OTHER OFFICIAL ACCESSORIES FOUND

Description of corner evidence found: At corner location found rotted stump with pieces of old blaze in it and part of "1/4" visible for N.E. BT. Found old partially rotted stump with part of blaze attached and part of "1/4" visible. At intersection of record distances from found stumps searched for remains of old yew post. Could find no trace of original post. Establish a point by measuring record distance from original BT stumps.

PLANE COORDINATE POSITION DATA

State _____ Zone _____
X _____
Y _____
Estab. By _____
Agency _____

Signature _____ Title _____ Division _____ Headquarters _____ Date _____

S/ HOWARD L. PERRY

PLS 1294

9/80

7100-52-(3.68)

CORNER RECORD (PERPETUATION)


Description of monument and accessories established to perpetuate the original location of this corner: At intersection point set 1"x30" pipe with 3" brass cap stamped:

Set pipe 24" in ground with mound of stone and dirt to cap.

CROWN T5N ZELLERBACH R38E

Bearing Trees:

Old: A Fir stump 34" diam bears N40°E, 18.5 ft with piece of blaze and part of "¼" visible.
 A Fir stump 30" dia bears N60°W 29.0 ft with part of blaze and "¼" visible.

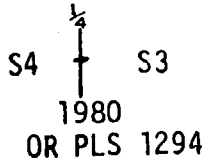

New: A White Fir 9" dia bears S79°E, 61.8 ft scribed ¼ S3 BT
 A White Fir 11" dia bears S39°W, 58.5 ft scribed ¼ S4 BT

Attached 54-3 & 54-4 signs on all BT's. Attached brass washer stamped LS 1294 to foot blaze of new BT's. Painted blazes & 6" band around new BT's red.

Surveying Co. Record Prepared? Yes No Title _____ Date _____ or Agency _____

REMARKS

Index File No. T. R. M. Tract or Surv. No. Cor.

C-13 5N 38E

4/3

T5N R38E C-13

1/4

ORIG SURVEY IN 1899 BY CAMPBELL

BEGIN SEARCH FROM PREVIOUSLY IDENTIFIED

SECTION CORNER $\frac{4/3}{9/10}$ (PAGE 5). RAN STAFF

COMPASS LINE NORTH AND STRINGBALL FOR DISTANCE

AREA ALONG ENTIRE ONE-HALF MILE HAS BEEN

LAGGED AND RE-LAGGED, MANY OLD STUMPS ARE PRESENT,

MOST OF WHICH ARE NEARLY ROTTEN AWAY. WE ARE UNABLE

TO FIND ANY EVIDENCE OF THE TWO LINE TREES CALLED

FOR IN THE ORIG. NOTES, HOWEVER THE TOPOGRAPHIC

FEATURES ALONG THE LINE AND THE CAL "STEEPER

DESCENT" AT 7.00 CHS. NORTH OF THE 1/4 CORNER AGREE

WELL WITH THE LINE THAT WE HAVE FOLLOWED.

SEARCH AREA IS NEAR MAIN ROAD, COURSE E-W.

WE ARE UNABLE TO FIND ANY EVIDENCE OF THE

CORNER AT THIS TIME.

5-21-80

Mary L. Knight ORLS 1099
GREG. ORTON

COMPASS DECL.: $19\frac{1}{2}^{\circ}$ EAST.

INDEX
FILE
T
MIG
COR



PHO
PHO
FILE
OBJ
INDEX
PLA
STO
X
Y
EST