

SDA-FOREST SERVICE

Index file No. C-7


CORNER RECORD (SEARCH)  
(Ref. FSM 7151.4)

Tract or Survey No. \_\_\_\_\_ Cor. No. \_\_\_\_\_

5N R. 38E  
Merid. WILL

R.D. W2 County UMATILLA  
N.F. UMATILLA State OREGON

CORNER DIAGRAM

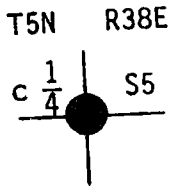

DESCRIBE CORNER MONUMENT FOUND

DESCRIBE BEARING TREES OR OTHER OFFICIAL ACCESSORIES FOUND

PHOTO IDENTIFICATION DATA

Photo No. \_\_\_\_\_  
Filed At. \_\_\_\_\_  
Object Ident. \_\_\_\_\_  
Ident. By \_\_\_\_\_  
*Signature*

DESCRIBE CORNER LOCATION RELATIVE TO NEAR-BY FEATURES, ALSO HOW TO REACH CORNER

PLANE COORDINATE POSITION DATA

State \_\_\_\_\_ Zone \_\_\_\_\_  
X \_\_\_\_\_  
Y \_\_\_\_\_  
Estab. By \_\_\_\_\_  
*Agency*

Signature HOWARD L. PERRY Title \_\_\_\_\_ Division PLS 1294 Headquarters \_\_\_\_\_ Date 10/80 7100-52-(3.68)

**CORNER RECORD (PERPETUATION)**

Description of monument and accessories established to perpetuate the original location of this corner:


At surveyed point set 1"x30" Galvanized Pipe with 3" brass cap stamped:

Set pipe 25" in ground. No stones available for mound.

New BTs:

A White Fir, 10" dia. bears N35<sup>0</sup>W, 28.0 ft., scribed C 1/4 S5 BT.

A Blue Spruce 8" dia. bears S75<sup>0</sup>W, 10.9 ft., scribed C 1/4 S5 BT.

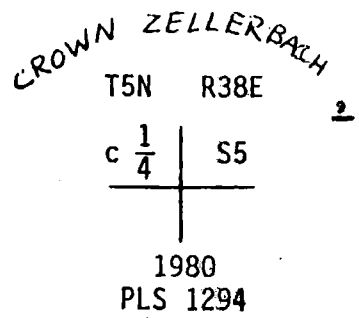

Attached 54-3 and 54-9 signs to both BTs. Attached brass washer stamped LS 1294 to foot blaze of both BTs. Painted blazes and 6" band around both BTs red.

REMARKS

Index File No.

C-7

T.

5N

R.

38E

M.

Trdet or Surv. No.

Cor.