

USDA-FOREST SERVICE

Index File No. H-9

CORNER RECORD (SEARCH)

(Ref. FSM 7151.4)

Tract or Survey No. _____ Cor. No. _____


T 5N R. 38E

R.D. W² County UMATILLA

Merid. WILL

N.F. UMATILLA State OREGON

CORNER DIAGRAM

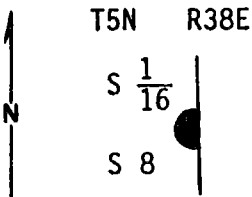

DESCRIBE CORNER MONUMENT FOUND

DESCRIBE BEARING TREES OR OTHER OFFICIAL ACCESSORIES FOUND

PHOTO IDENTIFICATION DATA

Photo No. _____

Filed At. _____

Object Ident. _____

Ident. By _____

Signature

PLANE COORDINATE POSITION DATA

State _____ Zone _____

X _____

Y _____

Estab. By _____

Agency

Signature

Title

Division

Headquarters

Date

7100-52-(3, 68)

1 HOWARD L. PERRY

PLS 1294

9/80

CORNER RECORD (PERPETUATION)

- Description of monument and accessories established to perpetuate the original location of this corner:

At surveyed point set a 1"x30" pipe with a 3" brass cap stamped:


Set corner 24" in ground. No stones for mound.

From which:

A White Fir 12" dia. bears S25⁰W 20.0 ft., scribed:
\$ 1/16 S8 BT.

A White Fir 18" dia. bears N55⁰W 31.8 ft., scribed:
\$ 1/16 S8 BT.

Attached 54-3 and 54-4 signs to both BTs. Attached brass washer stamped LS 1294 to foot blaze of both BTs. Painted blazes and 6" band around both BTs red.

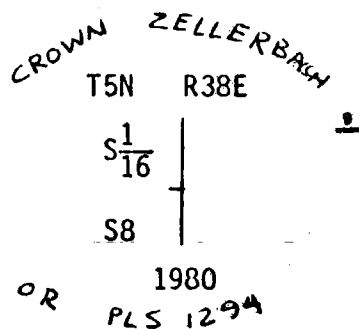

Continuing Cor. Record Prepared? Yes No Filed At: _____ Date: _____

REMARKS

Index File No. T. R. M. Tract or Surv. No. Cor.

H-9 5N 38E