

USDA-FOREST SERVICE

Index File No. H-9

CORNER RECORD (SEARCH)


(Ref. FSM 7151.4)

Tract or Survey No. _____ Cor. No. _____

T 5N R. 38E R.D. W² County UMATILLA

Merid. WILL N.F. UMATILLA State OREGON

CORNER DIAGRAM

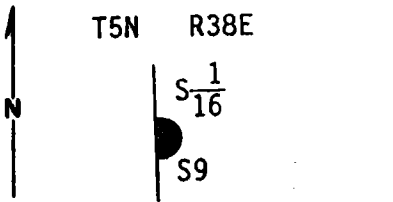

DESCRIBE CORNER MONUMENT FOUND

DESCRIBE BEARING TREES OR OTHER OFFICIAL ACCESSORIES FOUND

PHOTO IDENTIFICATION DATA

Photo No. _____

Filed At. _____

Object Ident. _____

Ident. By _____

Signature

DESCRIBE CORNER LOCATION RELATIVE TO NEAR-BY FEATURES, ALSO HOW TO REACH CORNER

PLANE COORDINATE POSITION DATA

State _____ Zone _____

X _____

Y _____

Estab. By _____

Agency

Signature _____ Title _____ Division _____ Headquarters _____ Date _____

(S) HOWARD L. PERRY

PLS 1294

9/80

7100-52 (3 68)

CORNER RECORD (PERPETUATION)

Description of monument and accessories established to perpetuate the original location of this corner:

At surveyed point set 1"x30" Galvanized Pipe with 3" brass cap stamped:

From which:

A White Fir 14" dia. bears N60°E 61.8 ft., scribed:
S 1/16 S9 BT.

A White Fir 7" dia. bears S26°E 64.9 ft., scribed
S 1/16 S9 BT.

Attached 54-3 and 54-4 signs to both BTs. Attached brass washer stamped LS 1294 to foot blaze of both BTs. Painted blazes and 6" band around both BTs red.

CROWN ZELLERBACH

T5N R38E

S 1/16

S9

1980

OR PLS 1294

Work Done By _____ Title _____ Date _____ State Registration No. or Agency _____

Certifying Cor. Record Prepared? Yes No Filed At: _____ Date _____ II

REMARKS

Index File No. T. R. M. Tract or Surv. No. Cor. II

H-9

5N

38E