

USDA-FOREST SERVICE

Index
File No. J-11

CORNER RECORD (SEARCH)


(Ref. FSM 7151.4)

Tract or
Survey No. _____ Cor.
No. _____

T 5N R. 38E R.D. W County UMATILLA

Merid. WILL N.F. UMATILLA State OREGON

CORNER DIAGRAM

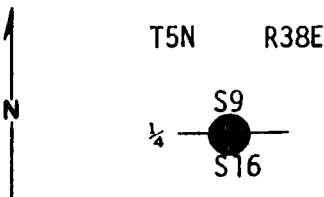

DESCRIBE CORNER MONUMENT FOUND

DESCRIBE BEARING TREES OR OTHER OFFICIAL ACCESSORIES FOUND

Description of corner evidence found: Original stone, firmly set with plain markings "1/4" on North face (markings oriented horizontally), the original stone mound has deteriorated from which:

An original 15" Fir, now a 24" Doug. Fir wind fall, lying approx. 15 ft East (downhill) from its original position, with a well healed blaze visible on the underneath portion of the tree, the root hole of which bears N17°E 27.7 ft. An original 26" Fir, now a 22" Doug. Fir standing and dead, with a well healed blaze bears S28°E 56.4 ft.

State _____ Zone _____

X _____

Y _____

Estab. By _____

Agency

Signature

Title

Division

Headquarters

Date

7100-52 (3-68)

S / HOWARD L. PERRY PLS 1294

10/80

CORNER RECORD (PERPETUATION)

Description of monument and accessories I established to perpetuate the original location of this corner: In place of stone set 1"x30" galvanized pipe with 3" brass cap. Buried pipe 20" in ground with original stone buried alongside; brass cap stamped: Built mound of stone to cap. From which:
 A Doug. Fir 13" dia bears S86⁰E 24.8 ft scribed ¼ S16 BT.
 A Doug. fir 8" dia bears N18⁰W 59.8 ft. scribed ¼ S9 BT.
 Attached 54-3 & 54-4 signs to both BT's. Attached brass washers stamped LS 1294 to foot blaze of both BT's.- Painted blazes and 6" band around both BT's red.

CROWN ZELLERBACH
 T5N R38E
 S9
 ¼ ———
 S16
 1980
 OR PLS 1294

Work Done By _____ Title _____ Date _____ State Registration No. _____
 or Agency _____
 Certified Cor. Record Prepared? Yes No Filed At: _____ Date _____

REMARKS

Index File No.	T.	R.	M.	Tract or Surv. No.	Cor.
J-11	5N	38E			

J-11

$\frac{9}{16} \frac{1}{4}$

T. 5N. R38E

FD: ORIGINAL STONE, FIRMLY SET, WITH PLAIN MARKINGS $\frac{1}{4}$ " ON NORTH FACE (MARKINGS ORIENTED HORIZONTALLY), THE ORIGINAL STONE MOUND HAS DETERIORATED, FROM WHICH THE ORIGINAL BEARING TREES:

AN ORIG. 15" FIR, NOW A ^{D. FIR} 24" WINDFALL, LYING APPROX 15 FEET ~~OR~~ EAST (DOWNHILL) FROM ITS ORIGINAL POSITION, WITH A WELL-HEALED BLAZE VISIBLE ON THE UNDERNEATH PORTION OF THE TREE, THE ROOT HOLE OF WHICH BEARS N 17° E 27² FT., (REC. N 17° E 42 LKS.),

AND AN ORIG. 26" FIR, NOW A 22" D. FIR, STANDING AND DEAD, WITH A WELL-HEALED BLAZE BEARS S 28° E 56² FT., (REC. S 35° E 88 LKS.)

Jerry L. Jorgit ORLS 1099
GREG ORTON

~~COMPASS~~ DECL: 19¹/₂° EAST


ORIGINAL SURVEY 1899 BY CAMPBELL

(OVER)

LAND
BUREAU
FIELD
FILE

T

Merid
CORNE

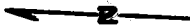

PHOTO

Photo

Filed

Object

Ident.

PLANE

State

X

Y

Estate

THIS CORNER IS LOCATED ON A STEEP EAST SLOPE
APPROX $3\frac{1}{2}$ CHS. EAST OF THE TOP OF AN N-S
GRASSY RIDGE. THE SE BT IS TAGGED AND
LOCATED ON TOP OF A SPUR RIDGE RUNNING SE.