

USDA-FOREST SERVICE

Index File No. J-5

CORNER RECORD (SEARCH)  
(Ref. FSM 7151.4)

Tract or Survey No. \_\_\_\_\_ Cor. No. \_\_\_\_\_


T 5N R. 38E

R.D. W<sup>2</sup> County UMATILLA

Merid. WILL

N.F. UMATILLA State OREGON

CORNER DIAGRAM

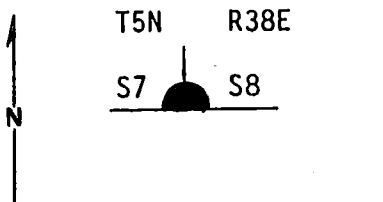

Description of corner evidence found:

A diligent search was made and no evidence of original stone or BTs could be found. Using calls to streams East, North and South established a point that fit the call distances very well. This evidence is believed to reestablish the corner as near to the original location as possible.

PHOTO IDENTIFICATION DATA

Photo No. \_\_\_\_\_  
 Filed At. \_\_\_\_\_  
 Object Ident. \_\_\_\_\_  
 Ident. By \_\_\_\_\_  
 Signature \_\_\_\_\_

DESCRIBE CORNER LOCATION RELATIVE TO NEAR-BY FEATURES, ALSO HOW TO REACH CORNER

PLANE COORDINATE POSITION DATA

State \_\_\_\_\_ Zone \_\_\_\_\_  
 X \_\_\_\_\_  
 Y \_\_\_\_\_  
 Estab. By \_\_\_\_\_  
 Agency \_\_\_\_\_

Signature

Title

Division

Headquarters

Date

7100-52-(3. 68)

HOWARD L. PERRY

PLS 1294

11/80

**CORNER RECORD (PERPETUATION)**

Description of monument and accessories | established to perpetuate the original location of this corner:

At established point set 1"x30" Galvanized Pipe with 3" brass cap stamped:

- Corner falls in shoulder of dirt road, set pipe 36" deep (6" below surface.)

From which:

A Douglas Fir bears N29½°W 100.1 ft. 8" dia., scribed:  
T5N R38E S7 BT.

A Spruce 12" dia. bears N74°E 54.4 ft., scribed:  
T5N R38E S8 BT.

- Attached 54-3 and 54-4 signs to both BTs. Attached brass washers stamped LS 1294 to foot blaze of both BTs. Painted blazes and 6" band around both BTs red.

CROWN ZELLERBACH  
T5N R38E  
S7 | S8  
1980  
OR PLS 1294

Index File No.

T.

R.

M.

Tract or Surv. No

Cor.

13

J-5

5N

38E

7/8

T 5 N R 38 E

J-5a

ORIG. SURVEY IN 1872 BY WILLIAMS

RETRACED IN 1899 BY CAMPBELL

SEARCH AREA LOCATED BY REFERENCE TO USGS  
TOPOG MAP AND MEASUREMENT FROM  $\frac{6}{5}$   
 $\frac{7}{8}$

TOPOGRAPHY CALLS ALONG WEST SIDE SEC. 8  
AND IN VICINITY OF  $\frac{7}{8}$  AGREE WELL WITH  
GROUND CONDITIONS. AREA HAS BEEN HEAVILY  
LOGGED AND, AT THE TIME OF THIS SEARCH,  
WAS COVERED BY APPROX 4 INCHES OF SNOW.

A STATE FORESTRY LOCATION POSTER WAS FOUND  
IN THE VICINITY BUT GAVE NO INFORMATION  
AS TO SPECIFIC CORNER LOCATION.

NO TRACES OF THIS CORNER WAS FOUND  
AT THIS TIME. THIS CORNER WAS RE-MONUMENT-  
ED WITH A STONE IN 1899.

5-28-80

*Greg Orton* ORLS 1099  
GREG ORTON

COMPASS DECL. 19 $\frac{1}{2}$ ° EAST,

PHOTO  
FILE

T  
M  
CORNER

← N →

PHOTO

PHOTO

FILE

OBJ

IDENT

FLAT

STATION

X

Y

EAST