

USDA-FOREST SERVICE

Index
File No. J-9

CORNER RECORD (SEARCH)

(Ref. FSM 7151.4)

Tract or
Survey No. _____ Cor.
No. _____


T 5N R. 38E

R.D. W² County UMATILLA

Merid. Will

N.F. UMATILLA State OREGON

CORNER DIAGRAM

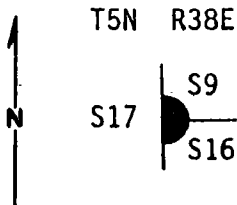

Description of corner evidence found:

Rock in place in ledge as described, with faint "+" on top and 4 notches on South and East edges, from which:

The only remaining Bearing Tree, now a 30" Douglas Fir, alive and in good condition, open and find good scribing "S", bears S88°E 66.8 ft.

PHOTO IDENTIFICATION DATA

Photo No. _____
Filed At. _____
Object Ident. _____
Ident. By _____

Signature

PLANE COORDINATE POSITION DATA

State _____ Zone _____
X _____
Y _____
Estab. By _____

Agency

Signature

Title

Division

Headquarters

Date

7100-52 (3 68)

151 HOWARD L. PERRY

PLS 1274

10/80

CORNER RECORD (PERPETUATION)

Description of monument and accessories I established to perpetuate the original location of this corner:

At point of "+" drilled hole with star drill and set 2½" brass tablet with 3/4"x3" shaft in hole with mortar stamped:

T5N R38E

- New BT:

A Douglas Fir 14" dia. bears N70E, 67.5 ft., scribed T5N R38E S9 BT.

S17	S9
	S16

1980

PLS 1294

Attached 54-3 and 54-4 signs to both BTs. Attached brass washer stamped LS 1294 to foot blaze of new BT. Painted blazes and 6" band around both BTs red.

Work Done By _____ Title _____ Date _____ State Registration No. or Agency _____ 10

Certified Cor. Record Prepared? Yes No Filed At: _____ Date _____ 11

REMARKS

Index File No. T. R. M. Tract or Surv. No. Cor. 12

J-9

5N 38E

J-9c

W
N CORNER SEC. 16

T. 5N R. 38 E

ORIGINAL SURVEY IN 1899 BY CAMPBELL

FD: ROCK IN PLACE IN LEDGE AS DESCRIBED,
WITH FAINT "+" ON TOP AND 4 NOTCHES ON
SOUTH AND EAST EDGES, FROM WHICH, IN

THE ONLY REMAINING ORIGINAL BEARING TREE,
AN ORIG. 18' FIR, NOW A 30" D. FIR, ALIVE AND
IN GOOD CONDITION, WE OPEN AND FIND GOOD
SCRIBING "S" BEARS S 88° E 66⁰ FT. (Roc
S 88° E 90 LBS.)

5-22-80

Mary L. Langley ORLS 1099
GREG ORTON

COMPASS DECL. 19 1/2° EAST.

CORNER IS LOCATED ON A STEEP, OPEN, ROCKY
EAST SLOPE APPROX 150 FT. EAST OF AN E-W
RIDGE AND APPROX 7.55 CHS SOUTH OF
NE COR. SEC. 17.



DATE
PAGE
FILE

T
M
O

INDEX
Photo
Filed
Obj
Label

PLA
Sta
X
Y
Elev

P

BLM

USDA-FOREST SERVICE

Index File No. J-9C


CORNER RECORD (SEARCH)
(Ref. FSM 7151.4)

Tract or Survey No. _____ Cor. No. J-9C

T 5N R. 38E R.D. _____ County _____

Merid. Williamette N.F. _____ State Oregon

CORNER DIAGRAM

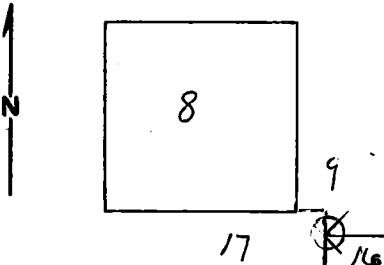

DESCRIBE CORNER MONUMENT FOUND

None

DESCRIBE BEARING TREES OR OTHER OFFICIAL ACCESSORIES FOUND

possibly B.T. fir 24 inches diam
S 88 E 90 115 dist,

PHOTO IDENTIFICATION DATA

Photo No. _____
Filed At. _____
Object Ident. _____
Ident. By _____
Signature

DESCRIBE CORNER LOCATION RELATIVE TO NEAR-BY FEATURES, ALSO HOW TO REACH CORNER

An old Wulla Wulla Mills location tag
describes corner in agreement with our
alleged location.

PLANE COORDINATE POSITION DATA

State _____ Zone _____
X _____
Y _____
Estab. By _____
Agency

John Christy Signature Title _____ Division _____ Headquarters _____ Date June 73

CORNER RECORD (PERPETUATION)

MONUMENT: DESCRIBE NEW MONUMENT SET, OR WORK DONE TO PRESERVE EXISTING MONUMENT

9

ACCESSORIES : DESCRIBE NEW BT'S WITNESS OBJECTS ETC. ESTABLISHED, OR WORK DONE TO PRESERVE EXISTING EVIDENCE

10

Work Done By _____ Title _____ Date _____ State Registration No.
or Agency _____

Certified Cor. Record Prepared ? Yes No Filed At: _____ Date _____ 11

REMARKS

12

Index File No. T. R. M. Tract or Surv. No. Cor. 13
U.S. G.P.O. 1977-725-576/586