


HISTORY OF ORIGINAL CORNER ESTABLISHMENT:

This record has been prepared to provide current information regarding the condition of the corner monument and accessories as described in the survey records cited below. Verification of the position of the corner monument and dimensions to existing accessories, and the establishment of new corner accessories was not performed as part of this visit.

The source of the monumentation and dimensions cited in this record is a Dependent Resurvey of ...Portions of the South and East Boundary, and Subdivisional Lines of Township 6 North, Range 38 East, Willamette Meridian, conducted by the Bureau of Land Management, commenced on October 13, 1987, and completed September 16, 1991.

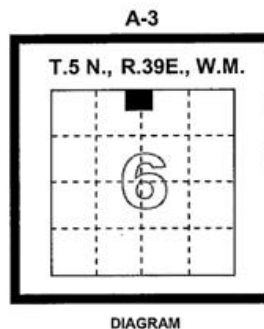

RECORD DESCRIPTION OF CORNER MONUMENT AND ACCESSORIES:

From the BLM Dependent Resurvey:

The ¼ sec. Cor. of sec. 6 only, T5N, R39E, monumented with an iron post, 1 in. dia., firmly set, protruding 5 in. above the ground, with brass cap mkd. (See diagram below), from which the remains of bearing trees marked by Gould:

- A root hole, bears S56°E 31 lks. dist., with shattered fir log lying alongside, with illegible scribe marks on rotted blaze (Record S47°E 35 lks.),
- A fir, 30 ins. diam., bears S 9 1/4°W 86 lks. dist., with healed blaze (Record S20°W)

DESCRIPTION OF MONUMENT AND ACCESSORIES FOUND AT THIS CORNER LOCATION:

Found:

A 2 ½" dia. Brass cap, marked as shown, on 1" iron pipe, leaning slightly NE, 8" above ground, from which:

The root hole (SE quadrant) is no longer discernable,

A 36" Engelmann Spruce, alive and in good condition, with healed single blaze (Gould SW bearing tree),

Additionally, we find the following corner accessories, for which we find no information in the Umatilla County, Oregon survey records, regarding their history:

A 10" Grand Fir, dead and leaning, with scribing "S6 ¼ BT" visible on an unhealed single blaze, and brass washer mkd. "OR2360 WA 25893" attached (SE quadrant),

And an 18" Engelmann Spruce, alive and in good condition with partial scribing visible on a nearly-healed single blaze (SE quadrant)

Corner is located on steep NE slope, in mixed timber and alder, approx. 100' NE of main USFS road.



I hereby certify that the above corner position was visited and found as described on October 17, 2005.

Witnesses: Tim Johnson, Gary Langlitz, Jeremy Jones

RECEIVED BY
Umatilla County Surveyor.
Date 1-06
Rec'd by KK
No. 06-08-R