

CORNER RECORD (SEARCH)

(Ref. FSM 5151.4)

Tract or
Survey No.

**Wenaha-Tucannon
Wilderness**

Cor.


No. **AP 85-09**

T. 5 N. R. 39 E.
Merid. Willamette

R.D. Pomeroy & Walla Walla
N.F. Umatilla

County Wallowa
State Oregon

CORNER DIAGRAM

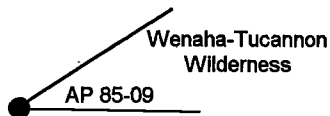

DESCRIBE CORNER MONUMENT FOUND

NONE

DESCRIBE BEARING TREES OR OTHER OFFICIAL ACCESSORIES FOUND

NONE

PHOTO IDENTIFICATION DATA

Photo No.
Filed At.
Object Ident.
Ident. By

Signature

DESCRIBE CORNER LOCATION RELATIVE TO NEAR-BY FEATURES, ALSO HOW TO REACH CORNER

From easterly junction of 6415 and 6415-020 travel easterly on 6415 approx. 0.15 miles and then walk northerly approx. 100 feet to the Angle Point.

PLANE COORDINATE POSITION DATA

State: Oregon Zone: North
X: 2701749.261 meters
Y: 247206.029 meters
Datum: NAD83(1991)

Signature

David Schlaich

Title

Land Surveyor

Division

Headquarters

S.O.

Date

10/1998

FS-7100-52 (3/97)

CORNER RECORD (PERPETUATION)

MONUMENT: DESCRIBE NEW MONUMENT SET, OR WORK DONE TO PRESERVE EXISTING MONUMENT

Set a 5/8" by 36" rebar, with a 3 1/4" aluminum cap, flush with the ground, stamped "W-T WILDERNESS AP 85-09 RLS 2308 1997".

ACCESSORIES: DESCRIBE NEW BT'S WITNESS OBJECTS ETC. ESTABLISHED, OR WORK DONE TO PRESERVE EXISTING EVIDENCE

10" Engelmann Spruce, N 65 1/2 E, 8.7 feet, scribed "WB/85-09" "BT".
6" White Fir, N 87 E, 27.0 feet, scribed "WB/85-09" "BT".

BT's are double blazed and have a 3/4" brass washer stamped "RLS 2308" nailed to the lower blaze by the "BT" scribing.

Work Done By David Schlaich Title Land Surveyor Date 10/1998 State Registration No. or Agency _____
Certified Corner Record Prepared? Yes No Filed At: _____ Date _____

REMARKS

Index File No.

T. **5 N.**

R. **39 E.**

M. **Willamette**

Tract or Survey No.

**Wenaha-Tucannon
Wilderness**

Cor. **AP 85-09**