


0-18

History of original corner establishment:

Unsurveyed - subdivided section

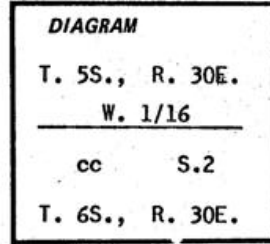

No record of subsequent remonumentation found in County Records.

Description of corner evidence found:

None.

Description of monument and accessories established to perpetuate the original location of this corner:

Set 2½" x 30" iron pipe 8" in ground with a brass cap marked as shown: From which I scribed Bearing Trees.


A 18" fir bears S. 35°56'W. 90.6 ft. mkd. W. 1/16cc S.2 BT.
A 11" fir bears S. 59°14' E. 13.4 ft. mkd. W.1/16cc S.2 BT.

Nailed a brass washer mkd. PLS 933 on the BT blaze on both trees. Set a steel fence post 3 ft. West of corner. Corner is South of a E-W fence line. Raised a mound of stone with a 4 ft. base within 4" of top of pipe. Used transit and steel tapes, measuring to the center of BT.

REGISTERED PROFESSIONAL LAND SURVEYOR

David H. Krumbain

OREGON
JULY 17, 1970
DAVID H. KRUMBEIN
933

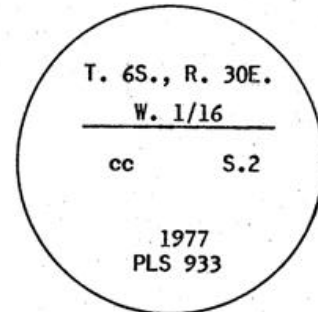

Office of.....County Surveyor..... County of.....Umatilla.....
State of.....Oregon....., I hereby certify that the within instrument was filed in this office
for record on the..... day of....., 19.....
David H. Krumbain by.....
(COUNTY OFFICIAL) (DEPUTY)