

USDA-FOREST SERVICE

Index  
File No. G-6

**CORNER RECORD (SEARCH)**


(Ref. FSM 7151.4)

Tract or Survey No. \_\_\_\_\_ Cor. No. \_\_\_\_\_

T 55 R. 30E R.D. Ukiah County Umatilla  
Merid. Willamette N.F. Umatilla State Ore.

(7)

**CORNER DIAGRAM**

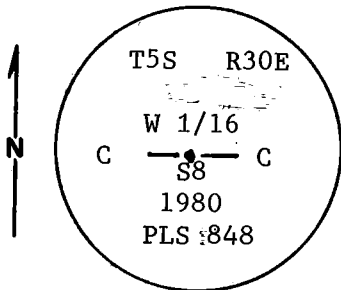

**DESCRIBE CORNER MONUMENT FOUND**

Corner not previously established.

**DESCRIBE BEARING TREES OR OTHER OFFICIAL ACCESSORIES FOUND**

N.A.

**PHOTO IDENTIFICATION DATA**

Photo No. \_\_\_\_\_  
Filed At. \_\_\_\_\_  
Object Ident. \_\_\_\_\_  
Ident. By \_\_\_\_\_  
*Signature*

**PLANE COORDINATE POSITION DATA**

State \_\_\_\_\_ Zone \_\_\_\_\_  
X \_\_\_\_\_  
Y \_\_\_\_\_  
Estab. By \_\_\_\_\_  
*Agency*

**DESCRIBE CORNER LOCATION RELATIVE TO NEAR-BY FEATURES, ALSO HOW TO REACH CORNER**

On road 5312 go SW approx. 1/2 mi. from Gilman ranch cabin, to the forest bdry. as marked. Then go approx. 800 ft. north along bdry. to corner. Corner is in a lodge pole pine thicket.

Signature

Title

Division

Headquarters

Date

7100-52-(3/68)

5

**CORNER RECORD (PERPETUATION)**

**MONUMENT: DESCRIBE NEW MONUMENT SET, OR WORK DONE TO PRESERVE EXISTING MONUMENT**

Set 3"x30" galv iron pipe with 3" brass cap, 24" in the ground. Stamped brass cap as shown in the diagram.

**ACCESSORIES : DESCRIBE NEW BT'S WITNESS OBJECTS ETC. ESTABLISHED, OR WORK DONE TO PRESERVE EXISTING EVIDENCE**

From Which:

A lodge pole pine 10" dia. bears N 61 W, 29.4 ft. scribed C W 1/16 S8 BT.

A " " " 5" dia. bears S 29 E, 4.3 ft. " " " " "

Nailed brass washers stamped PLS 848 & each bearing tree signs to each tree, painted red band around each tree.

Set steel posts with warning & bdry. signs, 5' S & 5' W.

Bearing-True Solar Grid

Work Done By D. M. Ferguson title Surveyor Date 9-4-80 State Registration No. or Agency PLS 848

Certified Copy Returned Prepared Yes  No  Filed At: \_\_\_\_\_ Date \_\_\_\_\_

**REGISTERED  
PROFESSIONAL  
LAND SURVEYOR**

REMARKS

Witness to above corner.

L. Wyllie

**OREGON  
JULY 12, 1968  
DOUGLAS M. FERGUSON  
848**

Index File No. \_\_\_\_\_ T. \_\_\_\_\_ R. \_\_\_\_\_ M. \_\_\_\_\_ Tract or Surv. No. \_\_\_\_\_ Cor. \_\_\_\_\_ U.S. G.P.O. 1977-725-576/586