

USDA-FOREST SERVICE

Index File No. H-8

CORNER RECORD (SEARCH)

(Ref. FSM 7151.4)

Tract or Survey No. _____ Cor. No. _____


T 55 R. 30E

R.D. Ukiah County Umatilla

Merid. Willamette

N.F. Umatilla State Oregon

CORNER DIAGRAM

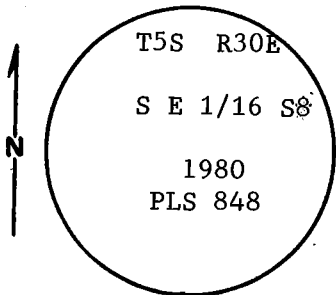

DESCRIBE CORNER MONUMENT FOUND

Corner not previously established.

DESCRIBE BEARING TREES OR OTHER OFFICIAL ACCESSORIES FOUND

N.A.

PHOTO IDENTIFICATION DATA

Photo No. _____

Filed At. _____

Object Ident. _____

Ident. By _____

Signature

PLANE COORDINATE POSITION DATA

State _____ Zone _____

X _____

Y _____

Estab. By _____

Agency

Signature

Title

Division

Headquarters

Date

7100-52-(3/68)

10

6

7

8

1

2

3

4

5

CORNER RECORD (PERPETUATION)

MONUMENT: DESCRIBE NEW MONUMENT SET, OR WORK DONE TO PRESERVE EXISTING MONUMENT

Set 3"x30" galv iron pipe with 3" brass cap stamped as shown in the diagram.
Set 26" in the ground.

ACCESSORIES : DESCRIBE NEW BT'S. WITNESS OBJECTS ETC. ESTABLISHED, OR WORK DONE TO PRESERVE EXISTING EVIDENCE

From which:

A tamarack 15" dia. bears N 21 E 8.9ft. scribed SE 1/16 S8 BT.

A lodge pole pine 8" dia. bears S 3 E 45.3 ft. " " " " "

Nailed brass washers stamped PLS 848 & bearing tree signs to each tree & steel posts painted red band around each tree.

Set steel posts 5'N & 5'W with bdry. & warning signs.

Bearing-mag. compass. 20 E Dec.

Work Done By: D. M. Ferguson Title Surveyor Date 9-3-80 State Registration No. or Agency PLS 848

Certified Cor. Record Prepared? Yes No Filed At: _____ Date _____

**REGISTERED
PROFESSIONAL
LAND SURVEYOR**

REMARKS

Witnesses to above corner.

D. Herburger

L. Wyllie

**OREGON
JULY 12, 1968
DOUGLAS M. FERGUSON
848**

Index File No. T. R. M. Tract or Surv. No. Cor. U.S. G.P.O. 1977-725-576/586