

USDA-FOREST SERVICE

Index  
File No. F-5 1/2

CORNER RECORD (SEARCH)


(Ref. FSM 7151.4)

Tract or  
Survey No. \_\_\_\_\_ Cor.  
No. \_\_\_\_\_

T 5S R. 30E R.D. Ukiah County Umatilla

Merid. Willamette N.F. Umatilla State Ore.

CORNER DIAGRAM

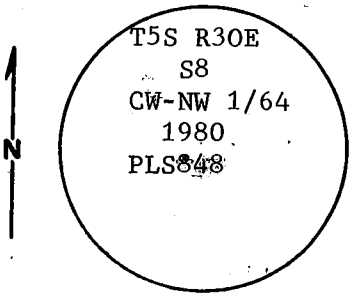

DESCRIBE CORNER MONUMENT FOUND

Corner Not Previously Established.

DESCRIBE BEARING TREES OR OTHER OFFICIAL ACCESSORIES FOUND

N.A.

PHOTO IDENTIFICATION DATA

Photo No. \_\_\_\_\_

Filed At. \_\_\_\_\_

Object Ident. \_\_\_\_\_

Ident. By \_\_\_\_\_

*Signature*

PLANE COORDINATE POSITION DATA

State \_\_\_\_\_ Zone \_\_\_\_\_

X \_\_\_\_\_

Y \_\_\_\_\_

Estab. By \_\_\_\_\_

*Agency*

Signature

Title

Division

Headquarters

Date

7100-52-(3/68)

**CORNER RECORD (PERPETUATION)**

**MONUMENT: DESCRIBE NEW MONUMENT SET, OR WORK DONE TO PRESERVE EXISTING MONUMENT**

Set 3"x30" galv. iron pipe 24" in the ground with brass cap stamped as shown on the diagram.

From which

**ACCESSORIES : DESCRIBE NEW BT'S WITNESS OBJECTS ETC. ESTABLISHED, OR WORK DONE TO PRESERVE EXISTING EVIDENCE**

A tamarack 14"dia bears S 69-W 23.7ft. scribed CW-NW 1/64 S8 BT  
A lodge pole pine 8"dia bears N 7-W 31.0ft. scribed CW-NW 1/64 BT  
Nailed brass washers stamped PLS 848 & bearing tree signs to each tree  
Painted red band around each tree.  
Set steel posts with bdry & warning signs 5'E & 5'S from corner.

Bearing-True Grid.

Work Done By D.M. Ferguson Title Supervisor Date 9-80 State Registration No. PLS 848  
or Agency

Certificate of Survey Prepared? Yes  No  Filed At: \_\_\_\_\_ Date \_\_\_\_\_

**PROFESSIONAL  
LAND SURVEYOR**

**REMARKS**

Witnesses to above corner.  
D. Herburger  
L. Wyllie

*Douglas M. Ferguson*  
**OREGON  
JULY 12, 1968  
DOUGLAS M. FERGUSON  
848**