


CERTIFIED RECORD OF LAND CORNER MONUMENTATION

History of original corner establishment: Corner established in 1880
by George S. Pershin, under contract No. 361
40.00 set basalt stone 16 x 8 x 7 on S. E. slope
for 1/4 sec. cor., from which
A pine 18 in. diam. brs. N. 10° W. 43 lks dist.
A pine 24 in. diam. brs. S. 28° E. 61 lks dist.

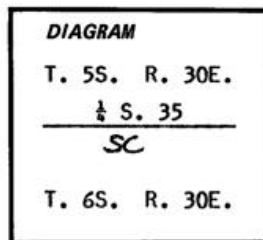


No record of subsequent remonumentation found in County Record.
Description of corner evidence found:

Found Stone 16X8X7 with 1/4 scribed on it in center of stone mound.
Found old BTs
A pine stump: 1/4 is on stump 28.80 ft. N. 11° W.
A 26" pine bears S. 26° E. 40.50 ft. uncovered BT

Description of monument and accessories established to perpetuate the original location of this corner:

Set 2 1/2" X 30" iron pipe with brass cap 15" in ground, put the stone along side pipe: brass cap marked as shown, from which I scribed new Bearing Tree.
A 26" pine bears N. 38° E. 70.6 ft. mkd T.5 S., R. 30 E., 1/4 S. 35 BT
I nailed a brass washer marked PLS 933 to the BT blaze of both trees. Set steel post 2 ft. West of corner. Corner is 75 ft. South of E-W Road and 97 ft. North of E-W fence line. Raised stone mound 3 ft. base within 4" to top of pipe. Used transit and steel tape, measuring to center of BT.

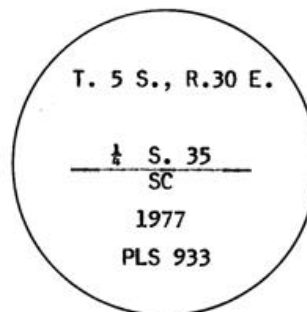

Office of..... County Surveyor..... County of..... Umatilla.....
State of..... Oregon....., I hereby certify that the within instrument was filed in this office
for record on the..... day of....., 19.....
..... by.....
(COUNTY OFFICIAL) (DEPUTY)

06-25-R