

USDA-FOREST SERVICE

Index

File No. Z-19

T55

R30E

Merid. Willanette

R.D.

N.F.

CORNER RECORD (SEARCH)

Ref. FSM 7151.4

North Fork John Day

Umatilla

Tract or

Survey No

County Umatilla

State Oregon

Cor.

No.

x

Corner Diagram

T55 R30E

1/4 S35

SC

1977

PLS 933

1 Describe corner monument found
 1 Steel pipe extending 15" above ground with 2 1/2" brass cap stamped as shown in
 1 the diagram. Monument is in stone mound.
 1
 1
 1

x

Photo Identification Data

Photo No. 1487-58

filed at Pendleton, OR

Object Ident. bearing trees

Ident. by D. Haddock

Signature

1 Describe bearing trees or other official accessories found
 1 A Ponderosa Pine stump bears N11 W, 28.8' scribed 1/4.
 1 A 26" Ponderosa Pine bears S26°E, 40.5' scribed BT.
 1 A 26" Ponderosa Pine bears N38°E, 70.6' scribed T55 R30E 1/4 S35 BT.
 1
 1

x

Plane Coordinate Position Data

State

Zone

X

Y

Estab. by

Agency

1 Describe corner location relative to near-by features, also how to reach corner
 1 From the junction of roads 5312 and 5320, follow 5320 east 1.6 miles to road
 1 5320110. Then follow road 5320110 east 1.9 miles to the end of the improved rock
 1 road. From the end of this road, walk west along the posted line approximately
 1 300' to the corner.
 1

x

Signature
David L. Haddock

Title
 Land Surveyor

Division

Headquarters
 Pendleton, OR

Date
 June 1988

7100.52

CORNER RECORD (PERPETUATION)

X-----X
 Monument: Describe new monument set, or work done to preserve existing monument

Set steel guard post 5' east of the monument and attached Forest Service Land Survey Monument and Property Boundary signs.

X-----X
 Accessories: Describe new BT's witness objects etc. established, or work done to preserve existing evidence

Repainted red bands around trees. Attached Forest Service Land Survey Monument signs to trees.

X-----X
 Work done by David L. Haddock Title Land Surveyor Date Nov 1988 State Registration No. 852
 Certified cor. record prepared? yes no x Filed at Date

X-----X
 REMARKS

X-----X
 Index File No. 7-19 T.5S. R.30E. M. Willamette Tract or Survey No Cor.

USDA-FOREST SERVICE

Index File No. Z-19

CORNER RECORD (SEARCH)


(Ref. FSM 7151.4)

Tract or Survey No. _____ Cor. No. _____

T 5S. R. 30E. R.D. Ukiah County Umatilla

Merid. Willamette N.F. Umatilla State Oregon

CORNER DIAGRAM

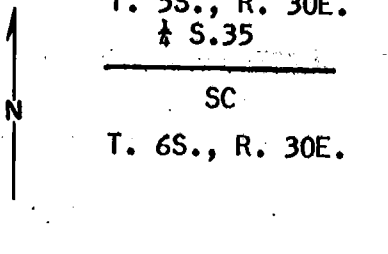

DESCRIBE CORNER MONUMENT FOUND

Found stone 16" x 8" x 7" with $\frac{1}{4}$ scribed on it in center of stone mound.

Set brass cap

2

DESCRIBE BEARING TREES OR OTHER OFFICIAL ACCESSORIES FOUND

Found old BTs:

A pine stump: $\frac{1}{4}$ is on stump N. 11^o W. 28.80 ft.
A 26" pine bears S. 26^o E. 40.50 ft. uncovered BT.

3

DESCRIBE CORNER LOCATION RELATIVE TO NEAR-BY FEATURES, ALSO HOW TO REACH CORNER

From intersection of U.S. Forest Roads 419 and 537, go East along 537 1.8 miles to Gulliford Crossing, then East 2.0 miles, then South 75 ft. to the corner.

4

PHOTO IDENTIFICATION DATA

Photo No. _____
Filed At. _____
Object Ident. _____
Ident. By _____
Signature

6

7

PLANE COORDINATE POSITION DATA

State _____ Zone _____
X _____
Y _____
Estab. By _____
Agency

8

Signature David H Miller

Title _____ Division OPLS Headquarters 933 Date 7-77 7100-52-(3/68)

5

CORNER RECORD (PERPETUATION)

MONUMENT: DESCRIBE NEW MONUMENT SET, OR WORK DONE TO PRESERVE EXISTING MONUMENT

Set 2½" x 30" iron pipe with brass cap, put stone along side pipe.

T. 5S., R. 30E.

¼ S.35

Pipe is 15" in ground.

Mound of stone to cap.

SC

1977

PLS 933

Stamped:

9

ACCESSORIES: DESCRIBE NEW BT'S WITNESS OBJECTS ETC. ESTABLISHED, OR WORK DONE TO PRESERVE EXISTING EVIDENCE

A 26" pine bears N. 38° E. 70.6 ft.

Set steel fence post 2 ft. West of corner w/sign.

Painted red band around bearing tree w/sign.

10

Work Done By T. Hamby Title Party Chief Date 6/23/77 State Registration No. _____
or Agency _____Certified Cor. Record Prepared? Yes No _____ Filed At: _____ Date _____

11

REMARKS

12

Index File No. _____ T. _____ R. _____ M. _____ Tract or Surv. No. _____ Cor. _____

13