

USDA-FOREST SERVICE

Index

File No. Z-9

T58

R30E

Merid. Willamette

R.D.

N.F.

CORNER RECORD (SEARCH)

Ref. FSM 7151.4

North Fork John Day

Umatilla

Tract or

Survey No

County Umatilla

State Oregon

Cor.

No.

x

Corner Diagram SC

T58 R30E

S32 | S23

T6SR30ES4

1976

OPLS 598

1 Describe corner monument found

1 Steel pipe extending 6" above the ground with a 2 1/2" brass cap stamped as shown in the diagram. The monument is in a mound of stone.

1

1

1

x

Photo Identification Data

Photo No.

filed at

Object Ident.

Ident. by

Signature

1 Describe bearing trees or other official accessories found

1 A 24" Douglas Fir bears N52°W, 46.2' scribed 30E S32 SC.

1 A 20" Douglas fir bears N34°E, 33.0' with healed scribe.

1

1

1

x

Plane Coordinate Position Data

State

Zone

X

Y

Estab. by

Agency

1 Describe corner location relative to near-by features, also how to reach corner

1 From the junction of roads 5312 and 5320, follow road 5320 east 0.5 mile to road 5320100. Follow road 5320100 0.6 mile south to an east-west fence, Follow this

1 fence east approximately 700' where the corner is located at the south edge of a jeep road.

1

x

Signature

David L. Haselock

Title

Land Surveyor

Division

Headquarters

Pendleton, OR

Date

June 1988

7100.52

CORNER RECORD (PERPETUATION)

X _____ X
 Monument: Describe new monument set, or work done to preserve existing monument

Set steel guard post 5' east of the monument and attached Forest Service Land Survey Monument and Property Boundary signs.

X _____ X
 Accessories: Describe new BT's witness objects etc. established, or work done to preserve existing evidence

Repainted red bands around trees. Attached Forest Service Land Survey Monument signs to trees.

X _____ X

Work done by	David L. Haddock	Title	Land Surveyor	Date	Nov 1988	State Registration No.	
Certified cor. record prepared?	yes		no x	Filed at		or Agency	852
						Date	

X _____ X
 REMARKS

X _____ X

Index File No.	7-9	T.55.	R.30E.	M. Willamette	Tract or Survey No	Cor.
----------------	-----	-------	--------	---------------	--------------------	------

USDA-FOREST SERVICE

Index File No. Z-9

CORNER RECORD (SEARCH)

(Ref. FSM 7151.4)

Tract or Survey No. _____ Cor. No. 2c

Z-9


T 55 R. 30E

R.D. UKIAH County UMATILLA

Merid. WILLAMETTE

N.F. UMATILLA State OR

CORNER DIAGRAM

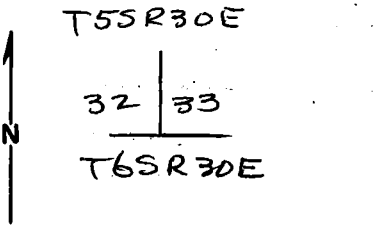

DESCRIBE CORNER MONUMENT FOUND.

FD. BASALT STONE 20X19X7" NOTCHED & LOOSELY SET IN MD. OF STONE.

DESCRIBE BEARING TREES OR OTHER OFFICIAL ACCESSORIES FOUND

A 24" FIR BRS NB20°W 462 FT MKD 30E 532 SC
A STUMP HOLE OF ROTTED PINE BRS N17°E 409 FT.

PHOTO IDENTIFICATION DATA

Photo No. _____
Filed At. _____
Object Ident. _____
Ident. By _____
Signature _____

DESCRIBE CORNER LOCATION RELATIVE TO NEAR-BY FEATURES, ALSO HOW TO REACH CORNER

COR IS 1 FT. SOUTH OF E-W FENCE.

PLANE COORDINATE POSITION DATA

State _____ Zone _____
X _____
Y _____
Estab. By _____
Agency _____

Signature _____ Title _____ Division _____ Headquarters _____ Date _____

CORNER RECORD (PERPETUATION)

MONUMENT: DESCRIBE NEW MONUMENT SET, OR WORK DONE TO PRESERVE EXISTING MONUMENT

SET 2 1/2" x 30" IRON PIPE W/ BRASS CAP HKD

SC
T55R30E
532 | 533
T65R30E SA
1976
OPLS 598

9

ACCESSORIES : DESCRIBE NEW BT'S WITNESS OBJECTS ETC. ESTABLISHED, OR WORK DONE TO PRESERVE EXISTING EVIDENCE

NEW BT

A 20" FIR BRS N34°E 330 FT HKD T55 R30E 533 SC BT

10

Work Done By R.D. Baggett Title Land Surveyor Date 9-30-76 State Registration No. OPLS 598
or Agency

Certified Cor. Record Prepared? Yes No Filed At: W MATILLA C.S. Date _____

11

REMARKS

Index File No. 2-9 T. R. M. Tract or Surv. No. Cor. _____

12

13