

Index. J-13  
File No. \_\_\_\_\_  
T 5S R. 31E  
Merid. Willamette


CORNER RECORD (SEARCH)

Tract or  
Survey No. \_\_\_\_\_

Cor. 24  
No. 16  
J-13

R.D. Ukiah County Umatilla  
N.F. Umatilla State Oregon

CORNER DIAGRAM

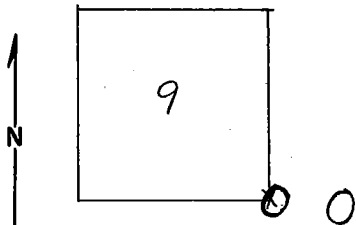

DESCRIBE CORNER MONUMENT FOUND

set basalt stone 16"10"x8" and post in mound of stone on level for cor to se. 9-10-15-16. No trees

DESCRIBE BEARING TREES OR OTHER OFFICIAL ACCESSORIES FOUND

PHOTO IDENTIFICATION DATA

Photo No. \_\_\_\_\_  
Filed At. \_\_\_\_\_  
Object Ident. \_\_\_\_\_  
Ident. By \_\_\_\_\_  
*Signature*

PLANE COORDINATE POSITION DATA

State \_\_\_\_\_ Zone \_\_\_\_\_  
X \_\_\_\_\_  
Y \_\_\_\_\_  
Estab. By \_\_\_\_\_  
*Agency*

DESCRIBE CORNER LOCATION RELATIVE TO NEAR-BY FEATURES, ALSO HOW TO REACH CORNER

In company with R. Swainston, D. Vawter, using a transit and phillie rod, beginning at  $\frac{1}{4}$  sec. cor. 9-10 South for 2640' to rock crib and fence running N&E. Put tag on rock crib and stake in ground for  $\frac{1}{4}$  cor. assumed.

Signature

Title

Division

Headquarters

Date

7100-52

*151 V. H. AVERETT*

*Eng. Aide*

*3-31-65*

REV. 65 5

CORNER RECORD (PERPETUATION)

MONUMENT: DESCRIBE NEW MONUMENT SET, OR WORK DONE TO PRESERVE EXISTING MONUMENT

9

ACCESSORIES DESCRIBE NEW BT'S WITNESS OBJECTS ETC. ESTABLISHED, OR WORK DONE TO PRESERVE EXISTING EVIDENCE

10

Work Done By \_\_\_\_\_ Title \_\_\_\_\_ Date \_\_\_\_\_ State Registration No. or Agency \_\_\_\_\_

Certified Cor. Record Prepared ? Yes No Filed At: \_\_\_\_\_ Date \_\_\_\_\_

11

REMARKS

12

Index File No. J-13 T. R. M. Tract or Surv. No. Cor. \_\_\_\_\_

13