

USDA-FOREST SERVICE

Index File No. N-3

CORNER RECORD (SEARCH)

(Ref. FSM 7151.4)

Tract or Survey No. Sec 19

Cor. No. N 1/4


T 5S R. 31E

R.D. Ukiah County Umatilla

Merid. Willamette

N.F. Umatilla State Oregon

CORNER DIAGRAM

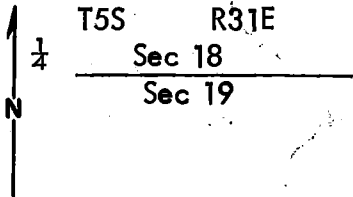

DESCRIBE CORNER MONUMENT FOUND

Found a basalt stone 18" x 15" x 5" with no markings

DESCRIBE BEARING TREES OR OTHER OFFICIAL ACCESSORIES FOUND

A 24" stump bears N84°W 73.9 ft. to center, no scribing found (rotted)
 A down and rotten pine bears S29°W 56.1 ft. from center, marked
 1/4 S BT

PHOTO IDENTIFICATION DATA

Photo No. _____
 Filed At. _____
 Object Ident. _____
 Ident. By _____
 Signature _____

DESCRIBE CORNER LOCATION RELATIVE TO NEAR-BY FEATURES, ALSO HOW TO REACH CORNER

An old road bears N150 ft.
 An East West fence Bears N3.4 ft.

PLANE COORDINATE POSITION DATA

State _____ Zone _____
 X _____
 Y _____
 Estab. By _____
 Agency _____

Signature Willie R. Wells

Title PLS 1106

Division _____

Headquarters _____

Date 7 29 79

7100-52-(3/68)

CORNER RECORD (PERPETUATION)

MONUMENT: DESCRIBE NEW MONUMENT SET, OR WORK DONE TO PRESERVE EXISTING MONUMENT

Set a 2" x 30" galvanized iron pipe with a brass cap 6" in ground with a mound of stone to the cap, marked: T5S R31E

Set a steel fence post West of corner and attached sign 54-4.

$\frac{1}{4}$ Sec 18
 $\frac{1}{4}$ Sec 19
 1979
 PLS 1106

ACCESSORIES : DESCRIBE NEW BT'S WITNESS OBJECTS ETC. ESTABLISHED, OR WORK DONE TO PRESERVE EXISTING EVIDENCE

A 10" bullpine bears S31 $\frac{1}{2}$ °W 19.6 ft. to center, marked $\frac{1}{4}$ S19BT

A 9 $\frac{1}{2}$ " bullpine bears N74°W 23.8 ft. to center, marked $\frac{1}{4}$ S18BT.

New BT's have a lower blaze scribed BT with a brass washer stamped PLS 1106 nailed flush.

Attached signs 54-3 & 54-4 and painted red ring around all BT"s.

10

Work Done By William R. Wells Title PLS Date 7 29 79 State Registration No. 1106
 or Agency

Certified Cor. Record Prepared? Yes No Filed At: Umatilla County Surveyors Office date _____

11

REMARKS

Witnesses: Greg Flowers. L.S.I.T.
 Brent Reynolds

Index File No. N-3

T. 5S

R. 31E

M. Willamette

Tract or Surv. No. Sec

Cor. N4 13
 U.S. G.P.O. 1977-725-576/586

12

USDA-FOREST SERVICE

Index
File No. N-3


CORNER RECORD (SEARCH)
(Ref. FSM 7151.4)

Tract or
Survey No. _____ No. _____

T 5S. R. 31E. R.D. Ukiah County _____

Merid. Willamette N.F. Umatilla State Oregon

CORNER DIAGRAM

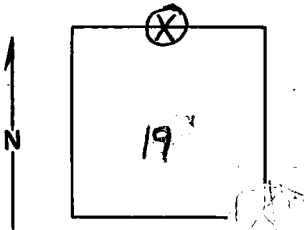

DESCRIBE CORNER MONUMENT FOUND

MATERIAL: Two stones, none exact call size
MARKINGS: No visible marks. Probably not in exactly proper location.

DESCRIBE BEARING TREES OR OTHER OFFICIAL ACCESSORIES FOUND

A 36" pond. pine stump bears approx. N 82° W., approx. 75 feet. Could find no scribing. A 16" pond. pine windfall bears approx. S 28° W, approx. 57 feet. I bucked out a section and found scribing, 1/4 S. A fence runs generally east-west, about 8 feet

North of stones.

PHOTO IDENTIFICATION DATA

Photo No. _____
Filed At. _____
Object Ident. _____
Ident. By _____
Signature

DESCRIBE CORNER LOCATION RELATIVE TO NEAR-BY FEATURES, ALSO HOW TO REACH CORNER

There are primitive roads in the ravines both north and south. There is a primitive road (approx. east-west) on ridgetop about 100' north of 1/4 corner. Did not trace it but believe it comes off the road in the ravine south. Probably branches in Sect. 13.

PLANE COORDINATE POSITION DATA

State _____ Zone _____
X _____
Y _____
Estab. By _____
Agency

Signature Tom Hollamon Title _____

Division _____ Headquarters _____

Date 4/18/78

7100-52-(3/68)

Kirk Moore

Eng. Tech

CORNER RECORD (PERPETUATION)

MONUMENT: DESCRIBE NEW MONUMENT SET, OR WORK DONE TO PRESERVE EXISTING MONUMENT

9

ACCESSORIES : DESCRIBE NEW BT'S WITNESS OBJECTS ETC. ESTABLISHED, OR WORK DONE TO PRESERVE EXISTING EVIDENCE

Placed BT tags on both the windfall and the piece I bucked out. Also on the stump which is in the proper location for other B.T.

10

Work Done By. _____ Title _____ Date _____ State Registration No. or Agency _____

Certified Cor. Record Prepared ? Yes No Filed At: _____ Date _____

11

REMARKS

BLM remonumentation rejected this corner in 1978. Don't know why.

12

Index File No. T. R. M. Tract or Surv. No. Cor. 13