

Index

File No. T-25

CORNER RECORD (SEARCH)


(Ref. FSM 7151.4)

Tract or
Survey No. _____Cor.
No. _____

87

T 5 S. R. 30 E. R.D. Ukiah County UmatillaMerid. Willamette N.F. Umatilla State Oregon

CORNER DIAGRAM

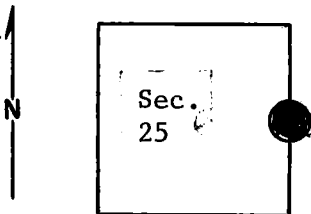

DESCRIBE CORNER MONUMENT FOUND

Stone mound, 3' diam., 10" deep, 10" above ground; good condition.

Mound consists of 7 or 8 stones. I cannot distinguish corner stone.

Monumented By BLM, 1978

DESCRIBE BEARING TREES OR OTHER OFFICIAL ACCESSORIES FOUND

A 24" ponderosa pine bears S.8°E., approx. 50 ft. It has old healed blaze facing corner and a line blaze (X) facing corner. I tagged it as a B.T., but it could be only a line tree.

A 24" ponderosa pine bears N.82°W., approx. 25 ft. Scribing visible. Has 1969 location poster. Tree blazed on 4 sides. Tree broken off about 30 ft. high, but is still alive (green limbs).

PHOTO IDENTIFICATION DATA

Photo No. _____

Filed At. _____

Object Ident. _____

Ident. By _____

Signature

PLANE COORDINATE POSITION DATA

State _____ Zone _____

X _____

Y _____

Estab. By _____

Agency

Signature

T. Hollamon

Title

Eng, Tech.,

Division

Headquarters

S.O.,

Date

4/24/74

7100-52-(3/68)

5

CORNER RECORD (PERPETUATION)

MONUMENT: DESCRIBE NEW MONUMENT SET, OR WORK DONE TO PRESERVE EXISTING MONUMENT

9

ACCESSORIES : DESCRIBE NEW BT's WITNESS OBJECTS ETC. ESTABLISHED, OR WORK DONE TO PRESERVE EXISTING EVIDENCE

I placed a location poster on a 5" ponderosa pine on west side of road,
approx. 150 ft. east.

I placed blank B.T. tags on the B.T.'s

10

Work Done By _____ Title _____ Date _____ State Registration No.
or Agency _____

Certified Cor. Record Prepared ? Yes No Filed At: _____ Date _____ 11

REMARKS

12

Index File No. T. R. M. Tract or Surv. No. Cor. 13