

CERTIFIED RECORD OF LAND CORNER MONUMENTATION


V - 21  
DIAGRAM

**History of original corner establishment:**

The original corner was established by George S. Pershin on October 4, 1880, under GLO contract No. 373, as follows:

Set a basalt stone, 16" x 12" x 8", on level in a mound of stones for corner to sections 25, 26, 35 and 36, from which:

- A 20" pine bears N43°E, 143 links (94.38 feet).
- A 28" pine bears S38°E, 116 links (76.56 feet).
- A 30" pine bears S60°W, 171 links (112.86 feet).

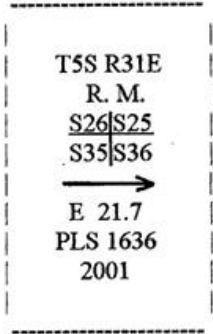

**Corner evidence recovered:**

The corner stone is gone. The corner point, as determined by reference to the original bearing tree evidence, is located in the westerly wheel track of a logging/jeep road. From the corner point:

A 34" recently sawn Ponderosa Pine stump bears S38°E, 76.56 feet. This is a very low cut stump, but I can see the lower portion of the healed lower blaze on the stump, and scribing is visible on the undercut lying alongside the stump.

A root hole, all that remains of the original northeast bearing tree, bears N43°E, 94.38 feet.

A root hole, all that remains of the original southwest bearing tree, bears S60°W, 112.86 feet.

**Monument and accessories established to perpetuate the original position of this corner:**

At the corner point, as determined by reference to the original bearing tree evidence, I set a 5/8" x 18" iron rod 20" into the ground. I use galvanized wire to attach a 3/4" brass washer, marked "PLS 1636", one inch below the top of the rod, from which:

A 1" x 30" galvanized iron pipe, with a 2 1/2" brass cap attached marked as shown in the diagram above, is set 27" into the ground and surrounded by a mound of earth and stones. This Reference Monument bears West, 21.7 feet.

A 14" Ponderosa Pine, scribed "T5S R31E S25 BT", bears N73° 45' E, 100.8 feet

A 16" Ponderosa Pine, scribed "T5S R31E S36 BT", bears S83°E, 83.6 feet.

A 13" Ponderosa Pine, scribed "T5S R31E S35 BT", bears S27°W, 73.1 feet.

A 13" Ponderosa Pine, scribed "T5S R31E S26 BT", bears N58°W to the base of the tree, which is leaning to the north, 44.2 feet .

The four new bearing trees are scribed on double blazes and have a 3/4" brass washer, marked "PLS 1636", nailed flush to the scribed "B". A "Bearing Object" sign is nailed above the blazes of the new bearing tree to the northwest.

I hereby certify the above corner point was perpetuated as hereon described on June 20, 2001.

Magnetic declination set in compass: 18° E.

*Dennis L. Gaylord*  
**REGISTERED PROFESSIONAL LAND SURVEYOR**  
 OREGON  
 JULY 14 1978  
 DENNIS L. GAYLORD  
 1636  
 Renews June 30, 2003

**RECEIVED BY**  
 Umatilla County Surveyor  
 Date 6-01  
 Rec'd By AK  
 No. 01-96-R

Recorded at the office of County Surveyor, County of Umatilla, State of Oregon, on \_\_\_\_\_, 2001.