

USDA-FOREST SERVICE


Index  
File No. J-1  
T 5S R. 33E  
Merid. Willamette

CORNER RECORD (SEARCH)  
(Ref. FSM 7151.4)

Tract or Survey No. S 18 Cor. No. NW Cor

R.D. Ukiah County Umatilla  
N.F. Umatilla State Oregon

CORNER DIAGRAM

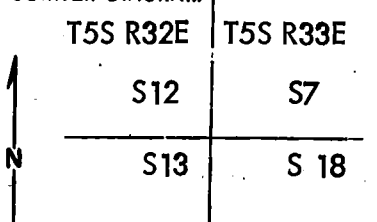

DESCRIBE CORNER MONUMENT FOUND

A mound of stone on North slope West of shallow draw.

DESCRIBE BEARING TREES OR OTHER OFFICIAL ACCESSORIES FOUND

Stump of a pine 30" dia. snag bears N74½°E 37.4 ft. to center scribed T5S R33E S5  
A 33" pine bears S14½°E 40.0 ft. to center, healed blaze, has been chopped out & appears to have been chopped too deep.

PHOTO IDENTIFICATION DATA

Photo No. \_\_\_\_\_  
Filed At. \_\_\_\_\_  
Object Ident. \_\_\_\_\_  
Ident. By \_\_\_\_\_  
*Signature*

DESCRIBE CORNER LOCATION RELATIVE TO NEAR-BY FEATURES, ALSO HOW TO REACH CORNER

A E-W Fence bears North 16.5 ft. from corner  
Corner of E.S. & N.S. fence bears N46°E 35 ft from corner  
Cable creek Road bears South 450' ± from corner  
There are no trees to put a location marker on. Drive 3½ miles ± along Cable Creek Road from Highway 244.

PLANE COORDINATE POSITION DATA

State \_\_\_\_\_ Zone \_\_\_\_\_  
X \_\_\_\_\_  
Y \_\_\_\_\_  
Estab. By \_\_\_\_\_  
*Agency*

Signature  
*William R. Wells*

Title  
PLS 1106

Division

Headquarters

Date  
7-25-79

7100-52-(3/68)

**CORNER RECORD (PERPETUATION)**

**MONUMENT: DESCRIBE NEW MONUMENT SET, OR WORK DONE TO PRESERVE EXISTING MONUMENT**

Set a 2" x 30" galvanized iron pipe 12" in the ground with a mound of stone to the cap marked;

Set a steel fence post North of corner & attached sign 54-4

T5S R32E S 12	T5S R33E S 7
S 13	S 18
1979	
PLS 1106	

**ACCESSORIES : DESCRIBE NEW BT'S WITNESS OBJECTS ETC. ESTABLISHED, OR WORK DONE TO PRESERVE EXISTING EVIDENCE**

A 13" bullpine bears N4 $\frac{1}{4}$ °W 57.3 to center, marked T5S R32E S12 BT

A 16 $\frac{1}{2}$ " bullpine bears N34°E 51.0 ft. to center, marked T5S R33E S7 BT

A 13 $\frac{1}{2}$ " bullpine bears S63°E 150.0 ft. to center, marked T5S R33E S18 BT

A 10 $\frac{1}{2}$ " bullpine bears S37°W 42.1 ft. to center, marked T5S R32E S13 BT

New BT's have a lower blaze scribed BT with a brass washer, stamped PLS 1106 nailed flush. Attached signs 54-3 & 54-4 and painted red ring around BT's.

Work Done By William R. Wells Title PLS Date 7 25 79 State Registration No. 1106  
or Agency

Certified Cor. Record Prepared ? Yes  No  Filed At: Umatilla County Surveyor's office Date \_\_\_\_\_

**REMARKS**

Witnesses: Greg Flowers L.S.I.T.  
Brent Reynolds

The ground is very rocky and we could not set monument any deeper.

Index File No.

5<sup>T</sup>

33E

M.  
Willamette

Tract or Surv. No.  
S18

Cor. NW .COR 13  
U.S. G.P.O. 1977-725-576/586

USDA-FOREST SERVICE

Index File No. J-1

**CORNER RECORD (SEARCH)**

(Ref. FSM 7151.4)

Tract or Survey No. \_\_\_\_\_ Cor. No. \_\_\_\_\_


T 5S R. 33E

R.D. Ukiah County Umatilla

Merid. Willamette

N.F. Umatilla State Oregon

**CORNER DIAGRAM**

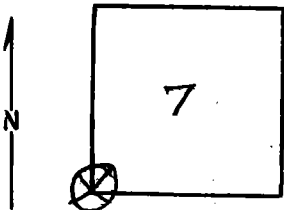

**DESCRIBE CORNER MONUMENT FOUND**

None.

**DESCRIBE BEARING TREES OR OTHER OFFICIAL ACCESSORIES FOUND**

NE quadrant: 18" p. pine snag, 10' high blazed SW face, scribed: T5S., R.33E., S 7.  
SE quadrant: 31" p. pine chopped north face.  
Fence west and north.

**PHOTO IDENTIFICATION DATA**

Photo No. \_\_\_\_\_  
Filed At. \_\_\_\_\_  
Object Ident. \_\_\_\_\_  
Ident. By \_\_\_\_\_  
*Signature*

**DESCRIBE CORNER LOCATION RELATIVE TO NEAR-BY FEATURES, ALSO HOW TO REACH CORNER**

**PLANE COORDINATE POSITION DATA**

State \_\_\_\_\_ Zone \_\_\_\_\_  
X \_\_\_\_\_  
Y \_\_\_\_\_  
Estab. By \_\_\_\_\_  
*Agency*

Signature B. Moore Title Eng. Tech. Division \_\_\_\_\_ Headquarters \_\_\_\_\_ Date 7/78 7100-52-(3/68)

**CORNER RECORD (PERPETUATION)**

**MONUMENT : DESCRIBE NEW MONUMENT SET, OR WORK DONE TO PRESERVE EXISTING MONUMENT**

9

**ACCESSORIES : DESCRIBE NEW BT'S WITNESS OBJECTS ETC. ESTABLISHED, OR WORK DONE TO PRESERVE EXISTING EVIDENCE**

10

Work Done By \_\_\_\_\_ Title \_\_\_\_\_ Date \_\_\_\_\_ State Registration No. or Agency \_\_\_\_\_

Certified Cor. Record Prepared ? Yes No Filed At: \_\_\_\_\_ Date \_\_\_\_\_

11

**REMARKS**

12

Index File No. T. R. M. Tract or Surv. No. Cor. \_\_\_\_\_

13