

USDA-FOREST SERVICE

Index

File No. A-15

CORNER RECORD (SEARCH)

(Ref. FSM 7151.4)

Tract or

Survey No. _____

Cor.

No. _____


T 58 R. 33E

R.D. Ukiah County Umatilla

Merid. W.M.

N.F. Umatilla State Or.

CORNER DIAGRAM

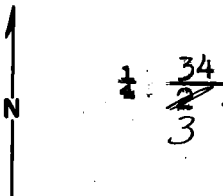

DESCRIBE CORNER MONUMENT FOUND

2 1/2" iron pipe with brass cap mkd:

T48 R33E

S34

~~8253~~

T58 R33E

1975

PLS 644

DESCRIBE BEARING TREES OR OTHER OFFICIAL ACCESSORIES FOUND

Lodgepole, 14", N10 1/2° W, 268.5 ft.

Lodgepole, 17", S71 1/4° E, 409.6 ft.

PHOTO IDENTIFICATION DATA

Photo No. _____

Filed At. _____

Object Ident. _____

Ident. By _____

Signature

DESCRIBE CORNER LOCATION RELATIVE TO NEAR-BY FEATURES, ALSO HOW TO REACH CORNER

Corner falls in pasture S. of Camas Cr. From gravel stockpile on S. side of Or. Hwy. 244 go S. to cor. in fence cor. Nly BT visible from hwy.

PLANE COORDINATE POSITION DATA

State _____ Zone _____

X _____

Y _____

Estab. By _____

Agency

Signature

F. C. Munro

Title

L.S.

Division

Headquarters

Date

9/26/84

7100-52-(3/68)

CORNER RECORD (PERPETUATION)

MONUMENT: DESCRIBE NEW MONUMENT SET, OR WORK DONE TO PRESERVE EXISTING MONUMENT

None.

ACCESSORIES: DESCRIBE NEW BT'S WITNESS OBJECTS ETC. ESTABLISHED, OR WORK DONE TO PRESERVE EXISTING EVIDENCE

BTs have reqd. paint, tags & signs.

Work Done By F.S. Munro Title L.S. Date 9/17/84 State Registration No. 1832
or Agency

Certified Cor. Record Prepared? Yes No Filed At: _____ Date _____

REMARKS

Index File No. A-15 T. 58 R. 33E M. W.M. Tract or Surv. No. _____ Cor. _____

Index File No. A-15

CORNER RECORD (SEARCH)

(Ref. FSM 7151.4)

Tract or Survey No. _____

Cor. No. A-15


T 53 R. 33E

R.D. UKIAH County UMATILLA

Merid. WM

N.F. UMATILLA State ORE

CORNER DIAGRAM

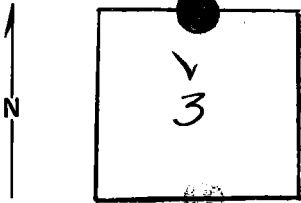

DESCRIBE CORNER MONUMENT FOUND

FOUND STONE BALL SIZE MARKED V

DESCRIBE BEARING TREES OR OTHER OFFICIAL ACCESSORIES FOUND

NONE

PHOTO IDENTIFICATION DATA

Photo No. _____

Filed At. _____

Object Ident. _____

Ident. By _____

Signature

PLANE COORDINATE POSITION DATA

State _____ Zone _____

X _____

Y _____

Estab. By _____

Agency

Signature

Title

Division

Headquarters

Date

7100-52 (3/68)

32 [Signature]

SURVEYOR

12/75

CORNER RECORD (PERPETUATION)

MONUMENT: DESCRIBE NEW MONUMENT SET, OR WORK DONE TO PRESERVE EXISTING MONUMENT

SET 2 1/2" X 30" IRON PIPE WITH BRASS CAP.

ACCESSORIES: DESCRIBE NEW BT's WITNESS OBJECTS ETC. ESTABLISHED, OR WORK DONE TO PRESERVE EXISTING EVIDENCE

NEW BTs

A 12" LODGE POLE PINE N8W, 268.6 FT

A 14" LODGE POLE PINE S70E, 409.0 FT

Work Done By D. I. GRIFFITH Title SURVEYOR Date 12/75 State Registration No. ORE PLS 644
or Agency

Certified Cor. Record Prepared? Yes No Filed At: UMATILLA Co. CT. HO Date 12/75

REMARKS

SEE MAP OF SURVEY DATED DEC. 1975

Index File No. A-15 T.55

R. 33E WM.

Tract or Surv. No.

Cor. A-15 13