

Index  
File No. E-15


**CORNER RECORD (SEARCH)**  
(Ref. FSM 7151.4)

Tract or  
Survey No. \_\_\_\_\_  
Cor. No. E-15

T 5S R. 33E  
Merid. WM

R.D. UKIAH County UMATILLA  
N.F. UMATILLA State ORE

CORNER DIAGRAM

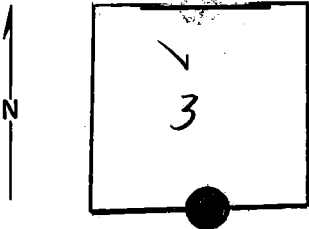

DESCRIBE CORNER MONUMENT FOUND

NONE

DESCRIBE BEARING TREES OR OTHER OFFICIAL ACCESSORIES FOUND

FOUND BOTH BTS  
SEE REMONUMENTATION SHT. FOR DETAILS

PHOTO IDENTIFICATION DATA

Photo No. \_\_\_\_\_  
Filed At. \_\_\_\_\_  
Object Ident. \_\_\_\_\_  
Ident. By \_\_\_\_\_  
*Signature*

PLANE COORDINATE POSITION DATA

State \_\_\_\_\_ Zone \_\_\_\_\_  
X \_\_\_\_\_  
Y \_\_\_\_\_  
Estab. By \_\_\_\_\_  
*Agency*

DESCRIBE CORNER LOCATION RELATIVE TO NEAR-BY FEATURES, ALSO HOW TO REACH CORNER

*Signature*

Title

Division

Headquarters

Date

SURVEYOR

12/75 100-52 (3/68)

(34)

CORNER RECORD (PERPETUATION) ✓

MONUMENT: DESCRIBE NEW MONUMENT SET, OR WORK DONE TO PRESERVE EXISTING MONUMENT

SET 2½" X 30" IRON PIPE WITH BRASS CAP  
AT RECORD BNG, AND DIST. FROM NE BT.

ACCESSORIES : DESCRIBE NEW BT'S WITNESS OBJECTS ETC. ESTABLISHED, OR WORK DONE TO PRESERVE EXISTING EVIDENCE 9

NEW BT'S

A 8" FIR S34E, 36.2 FT  
A 8" FIR N65W, 18.7 FT

Work Done By DI. GRIFFIN Title SURVEYOR Date 12/75 State Registration No. or Agency ORE PLS 699 10

Certified Cor. Record Prepared? Yes  No  Filed At: UMATILLA Co. CT. HQ. Date 12/75 11

REMARKS

SEE MAP OR SURVEY DATED DEC. 1975

Index File No. E.15 T. 5S R. 33E W.M.

Tract or Surv. No.

Cor. E.15 12  
13