

(PA)

CORNER RECORD (SEARCH)

Tract or Survey No. \_\_\_\_\_

Cor. No. G-17

Index File No. G-17


T 5S R. 33E

R.D. UKIAH County UMATILLA

Merid. WILLAMETTE

N.F. UMATILLA State OREGON

CORNER DIAGRAM

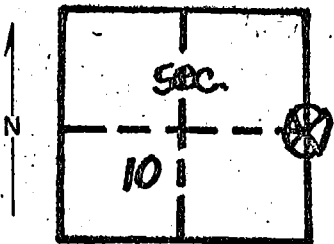

DESCRIBE CORNER MONUMENT FOUND

Material: Stone, size: 12x10x16, condition: good, Markings:  $\frac{1}{4}$

DESCRIBE BEARING TREES OR OTHER OFFICIAL ACCESSORIES FOUND

One Tamerack snag 10" DBH was found very near to fall over. No other bearing trees could be found. Bears N. 31 degrees W 19 links from corner.

PHOTO IDENTIFICATION DATA

Photo No. \_\_\_\_\_  
Filed At. \_\_\_\_\_  
Object Ident. \_\_\_\_\_  
Ident. By \_\_\_\_\_  
*Signature*

DESCRIBE CORNER LOCATION RELATIVE TO NEAR-BY FEATURES, ALSO HOW TO REACH CORNER

Scribed a 9.4" DBH Douglas Fir tree bearing N 64 degrees E from stone and 28' or about 42 links. Purpose is to preserve corner.

PLANE COORDINATE POSITION DATA

State \_\_\_\_\_ Zone \_\_\_\_\_  
X \_\_\_\_\_  
Y \_\_\_\_\_  
Estab. By \_\_\_\_\_  
*Agency*

Signature: \_\_\_\_\_

Title

Division

Headquarters

Date

7100-52

M.L.C.

For. tech

USFS

Ukiah

9/28/73

REV. 65