

USDA-FOREST SERVICE

Index File No. G-9

CORNER RECORD (SEARCH)

(Ref. FSM 7151.4)

Tract or Survey No. Sec 9

Cor. No. W 1/4


T 5S R. 33E

R.D. Ukiah County Union

Merid. Willamette

N.F. Umatilla State Oregon

CORNER DIAGRAM

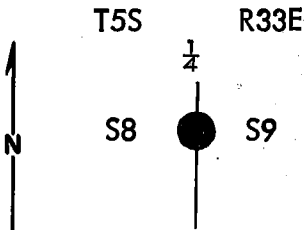

DESCRIBE CORNER MONUMENT FOUND

Found a Basalt stone 16" x 10" x 8" buried about 6", no evidence of chisel marks,

DESCRIBE BEARING TREES OR OTHER OFFICIAL ACCESSORIES FOUND

A 20" down and dead pine bears N38°W - 17.2 ft. scribed 1/4 SBT

PHOTO IDENTIFICATION DATA

Photo No. _____
 Filed At. _____
 Object Ident. _____
 Ident. By _____
 Signature _____

DESCRIBE CORNER LOCATION RELATIVE TO NEAR-BY FEATURES, ALSO HOW TO REACH CORNER

From the S.E. corner of Sec. 9 drive West on road along the South line of Sec. 9 .8 mi. to draw, turn north down draw to old road that runs along the West side of the draw, drive .4 mi. corner is 20' East of old road in clearing.

PLANE COORDINATE POSITION DATA

State _____ Zone _____
 X _____
 Y _____
 Estab. By _____
 Agency _____

Signature

Willie R. Wells

Title

PLS 1106

Division

Headquarters

Date

7-2-79

7100-52-(3/68)

CORNER RECORD (PERPETUATION)

MONUMENT: DESCRIBE NEW MONUMENT SET, OR WORK DONE TO PRESERVE EXISTING MONUMENT

Set 2" x 30" iron pipe with brass cap 12" in ground to rock with a mound of stone to cap, marked: T5S R33E

Set steel fence post on section line S of corner and attached sign 54-4, S8 1/4 S9
1979 PLS 1106

Buried stone by monument on North side.

ACCESSORIES: DESCRIBE NEW BT'S WITNESS OBJECTS ETC. ESTABLISHED, OR WORK DONE TO PRESERVE EXISTING EVIDENCE

A 10 1/2" red fir bears N81°W 83.5 ft. to center, scribed 1/4 S8BT

A 21" red fir bears S37°E 84.6 ft. to center, scribed 1/4 S9BT

New BT's have a lower blaze scribed BT with a brass washer stamped PLS 1106 nailed flush

Attached signs 54-3 and 54-4 and painted red ring around all BT's.

Work Done By William R. Wells Title PLS Date 7-2-79 State Registration No. or Agency 1106

Certified Cor. Record Prepared? Yes No Filed At: Umatilla County Surveyor's office Date _____

REMARKS

Witnesses: Greg Flowers, L.S.I.T.
Brent Reynolds

USDA-FOREST SERVICE

Index
File No. G-9

CORNER RECORD (SEARCH)
(Ref. FSM 7151.4)

Tract or
Survey No. _____ Cor. No. G-9


T 5S R. 33E

R.D. Ukiah County Umatilla

Merid. Willamette

N.F. Umatilla State Oregon

CORNER DIAGRAM

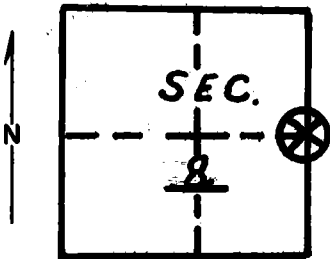

DESCRIBE CORNER MONUMENT FOUND

Material: None
~~Markings:~~ Destroyed by skid road.
Area

DESCRIBE BEARING TREES OR OTHER OFFICIAL ACCESSORIES FOUND

22" down, rotten P. Pine in N.E. Quadrant with blaze on top, scribed: 1/4 S B.T.. Stump hole in N.W. Quadrant.

PHOTO IDENTIFICATION DATA

Photo No. _____
Filed At. _____
Object Ident. _____
Ident. By _____
Signature

DESCRIBE CORNER LOCATION RELATIVE TO NEAR-BY FEATURES, ALSO HOW TO REACH CORNER

Location of 1/4 corner is approximately 200' West of draw on slight N.E. slope.

PLANE COORDINATE POSITION DATA

State _____ Zone _____
X _____
Y _____
Estab. By _____
Agency

Signature
Bill Moore

Title
Eng. Tech.

Division _____ Headquarters _____

Date
7/77

7100-52-(3/68)

CORNER RECORD (PERPETUATION)

MONUMENT: DESCRIBE NEW MONUMENT SET, OR WORK DONE TO PRESERVE EXISTING MONUMENT

9

ACCESSORIES : DESCRIBE NEW BT'S WITNESS OBJECTS ETC. ESTABLISHED, OR WORK DONE TO PRESERVE EXISTING EVIDENCE

I placed a blank FS bearing tree poster above blaze and attention poster North side of down B.T.

10

Work Done By _____ Title _____ Date _____ State Registration No. or Agency _____

Certified Cor. Record Prepared ? Yes No Filed At: _____ Date _____

11

REMARKS

12

Index File No. T. R. M. Tract or Surv. No. Cor. 13