

USDA-FOREST SERVICE

Index

File No. K-25

T 5S R. 33 E

Merid. Willamette

CORNER RECORD (SEARCH)

(Ref. FSM 7151.4)

R.D. Ukiah

County Umatilla


N.F. Umatilla

State Oregon

Tract or Survey No. _____

Cor. N 1
No. 16

CORNER DIAGRAM

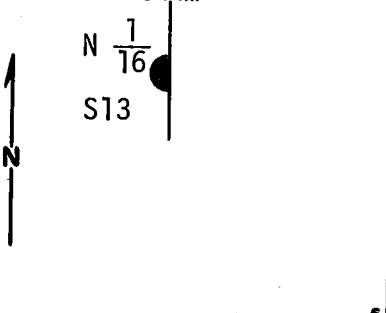

DESCRIBE CORNER MONUMENT FOUND

None Set

DESCRIBE BEARING TREES OR OTHER OFFICIAL ACCESSORIES FOUND

None Set

PHOTO IDENTIFICATION DATA

Photo No. _____

Filed At. _____

Object Ident. _____

Ident. By _____

Signature

PLANE COORDINATE POSITION DATA

State _____ Zone _____

X _____

Y _____

Estab. By _____

Agency

DESCRIBE CORNER LOCATION RELATIVE TO NEAR-BY FEATURES, ALSO HOW TO REACH CORNER

Corner falls 80 ft. south and 40 ft. west of N-W fence corner and 100 Ft. west of USFS Rd. No. 5226-060

Signature
Howard J. Samp

Title

Division
ORLS

Headquarters
1294

Date
9-77


7100-52-(3/68)

CORNER RECORD (PERPETUATION)

MONUMENT: DESCRIBE NEW MONUMENT SET, OR WORK DONE TO PRESERVE EXISTING MONUMENT

At surveyed point set 2 1/2"X30" galvanized pipe with brass stamped:

Set pipe 24" in ground with mound of stone to cap.

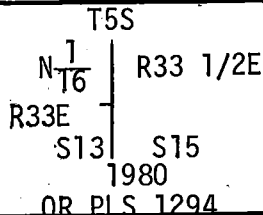

ACCESSORIES : DESCRIBE NEW BT'S WITNESS OBJECTS ETC. ESTABLISHED, OR WORK DONE TO PRESERVE EXISTING EVIDENCE

Bearing Trees:

A White Fir 14" dia bears N69⁰W, 24.5 ft., scribed N1/16 S13 BT.

A White Fir 12" dia bears S83⁰W, 23.5 ft., scribed N1/16 S13 BT.

Attached 54-3 & 54-4 signs to both BTs. Attached brass washer stamped LS 1294 to foot blaze of both BTs. Painted blazes and 6" band around both BTs Red.

Attached 54-2 & 54-4 signs to metal post 5 ft west of corner. Attached 54-2 & 54-9 signs to metal post 5 ft north of corner.

Work Done By: R. C. Orton Title Party Chief Date 7-9-80 State Registration No. or Agency _____

Certified Cor. Record Prepared ? (Yes) No Filed At: _____ Date _____

REMARKS

Witnesses: R. Orton
L. Huntsman
D. Allen

Index File No. K-25 T. 5S R. 33E M. _____ Tract or Surv. No. _____ U.S. G.P.O. Cor. 1977-725-576/586