N-5

History of original corner establishment:

Corner was established by George S. Pershin in 1882 under contract # 430

Set was a square post 4" x 4" long in a mound of stone marked "T 5 S, S 17" on N.E. side and "R 33 E, S 20" on S.E. side also set a Basalt stone 16" x 10" x 7" in mound of stone marked with 3 notches on the South side and 5 notches on the East side

DIAGRAM T55 R 33 E 618 | 517 B19 | 520

Description of corner evidence found:

None

Description of monument and accessories I established to perpetuate the original location of this corner: By Proportionate Method

Set a $2\frac{1}{2}$ " dia. Brass Cap on a $2\frac{1}{2}$ " x 30" galvanized pipe in the ground with a mound of stones around the Brass Cap which is stamped as shown:

From which I scribed the Bearing Trees

A 10" dia. Pondarosa Pine bears S 57° E, 242.0 feet scribed T5S R33E S20 BT

A 8" dia. Pondarosa Pine bears N 89° E, 332.0 feet scribed T5S R33E S17 BT

Since trees were not available in Sections 18 & 19, 5/8" iron pins with $1\frac{1}{2}$ " aluminum caps stamped with an arrow, PtS:933 and a distance to the corner were set as follows:

A 5/8" iron pin bears S 67° W, 13.3 feet A 5/8" iron pin bears N 28° W, 22.1 feet


Bearing trees have: A brass Washer stamped PLS nailed to the BT scribe painted band around the tree and on the face of the scribe, signs # 54-3 & 54-4

Bearing trees were measured horizontally with steel tape to the center of the tree and a magnetic compass with a 190 East variation.

Witness: R. Punches

S. Carlson

Aug. 6, 1984

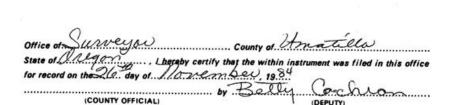

Form R6-7100-57 (9/71)

GPO-798-276