

Index
File No. P-11

CORNER RECORD (SEARCH)

(Ref. FSM 7151.4)

Tract or
Survey No. _____ Cor.
No. _____


T 55 R. 33E

R.D. N. Fork JOHN DAY County UMATILLA

Merid. Will.

N.F. UMATILLA State OR

CORNER DIAGRAM

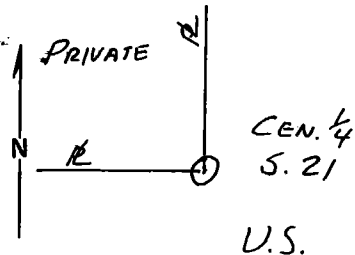

DESCRIBE CORNER MONUMENT FOUND

2" GALV. I. PIPE WITH 2 1/2" BR. CAP, MKD. AS SHOWN

NOTE: I DO NOT ACCEPT THIS CORNER
SEE OTHER SIDE.

T55 R33E
C 1/4 - S 21
1984
PLS 933 2

DESCRIBE BEARING TREES OR OTHER OFFICIAL ACCESSORIES FOUND

PHOTO IDENTIFICATION DATA

Photo No. _____
Filed At. _____
Object Ident. _____
Ident. By _____

Signature _____ 7

DESCRIBE CORNER LOCATION RELATIVE TO NEAR-BY FEATURES, ALSO HOW TO REACH CORNER

LIES ON E. SLOPE, ABOUT 75' W. OF CREEK BOTTOM

PLANE COORDINATE POSITION DATA

State _____ Zone _____
X _____
Y _____
Estab. By _____
Agency _____ 8

Signature
John McNeil

Title
LS.

Division

Headquarters

Date
9-10-85

FS-7100-52 (3/68)

CORNER RECORD (PERPETUATION)

MONUMENT: DESCRIBE NEW MONUMENT SET, OR WORK DONE TO PRESERVE EXISTING MONUMENT

AT POINT OF INTERSECTION OF E-W $\frac{1}{4}$ AND N-S $\frac{1}{4}$ OF SEC. 21 I SET A 2" x 30" ALUMINUM PIPE WITH 2 1/2" AL. CAP, M.K.O. AS SHOWN \rightarrow 26" IN GROUND, IN A STONE MOUND.

T55 R33E

C 1/4 . S21

1985

RLS 934

9

ACCESSORIES : DESCRIBE NEW BT'S WITNESS OBJECTS ETC. ESTABLISHED, OR WORK DONE TO PRESERVE EXISTING EVIDENCE

I BLAZED & SCRIBED 2 NEW BT'S AS FOLLOWS:

8" LARCH, SCRIBED "C 1/4 S21 BT", BEARS S30°W, 47.7 FT.

8" FIR, SCRIBED "C 1/4 S21 BT", BEARS N83°W, 27.3 FT.

10

Work Done By V. McLIND Title LS Date 9-15-85 State Registration No. 934
or Agency

Certified Cor. Record Prepared ? Yes No Filed At: _____ Date _____

11

REMARKS

KRUMBEIN'S BR. CAP FOR THE GEN. 1/4 COR. BEARS S78°39'40"E, 23.73 FT. FROM MY CORNER.

12

Index File No. P-11 T. 55 R. 33E M. WILL. Tract or Surv. No. _____ Cor. _____

13

USDA-FOREST SERVICE


Index
 File No. P-11
 T 53 R. 33E
 Merid. Willamette

CORNER RECORD (SEARCH)

(Ref. FSM 7151.4)

Tract or Survey No. _____
 Cor. No. C/4
 R.D. Ukiah County Umatilla
 N.F. Umatilla State Oregon

CORNER DIAGRAM

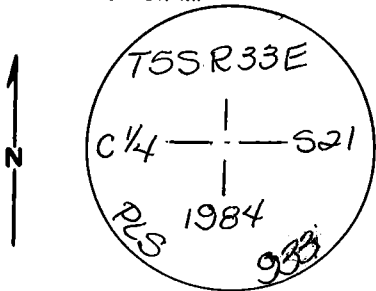

DESCRIBE CORNER MONUMENT FOUND

None

DESCRIBE BEARING TREES OR OTHER OFFICIAL ACCESSORIES FOUND

None

PHOTO IDENTIFICATION DATA

Photo No. _____
 Filed At. _____
 Object Ident. _____
 Ident. By _____
 Signature _____

PLANE COORDINATE POSITION DATA

State _____ Zone _____
 X _____
 Y _____
 Estab. By _____
 Agency _____

DESCRIBE CORNER LOCATION RELATIVE TO NEAR-BY FEATURES, ALSO HOW TO REACH CORNER

From Hiway Springs drive SE 0.6 mi.,
 Follow Creek South 0.4 mi to corner

Signature
David H Klee

Title
PLS 933

Division

Headquarters

Date

7/16/84

7100-52 (3, 68)

CORNER RECORD (PERPETUATION)

MONUMENT: DESCRIBE NEW MONUMENT SET, OR WORK DONE TO PRESERVE EXISTING MONUMENT

Set a 2 1/2" Brass Cap on a 2 1/2" x 30" galvanized pipe set 12" in the ground.
Built a stone mound around the B.C.

ACCESSORIES : DESCRIBE NEW BT'S WITNESS OBJECTS ETC. ESTABLISHED, OR WORK DONE TO PRESERVE EXISTING EVIDENCE

A 7" dia. lodge pole Pine bears N 59° W, 13.8 feet
A 7" dia. lodge pole Pine bears N 83° E, 16.7 feet
Steel fence post by corner with sign #54-4
Trees have signs #54-3, 54-4 and Brass washers

Work Done By R Panches Title Party Chief Date 7/9/84 State Registration No. or Agency _____

Certified Cor. Record Prepared? Yes No Filed At: Umatilla County Surveyor Date 7-24-84

REMARKS