

USDA-FOREST SERVICE


Index
File No. R-9
T 55 R. 33E
Merid. Willamette

CORNER RECORD (SEARCH)

(Ref. FSM 7151.4)

Tract or Survey No. _____
R.D. Ukiah County Umatilla
N.F. Umatilla State Oregon
Cor. No. Sec Cor

CORNER DIAGRAM

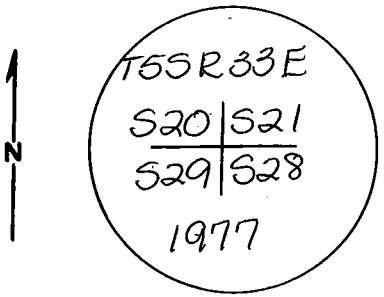

DESCRIBE CORNER MONUMENT FOUND

Found a 2 1/2" dia. Brass Cap in a well grown over stone mound set by the BLM

DESCRIBE BEARING TREES OR OTHER OFFICIAL ACCESSORIES FOUND

A 40" Ponderosa Pine bears N40°W, 141 IKS
A 15" Ponderosa Pine bears N45° E, 34 IKS
A 24" Ponderosa Pine bears S 44° E, 56 IKS
A 24" Tamarack bears S 57° W, 86 IKS
All trees have clearly visible scribing

DESCRIBE CORNER LOCATION RELATIVE TO NEAR-BY FEATURES, ALSO HOW TO REACH CORNER

From Hiaway Springs, go South on Rd 5450 2.4 mi, corner is 0.1 mi on left

PHOTO IDENTIFICATION DATA

Photo No. _____
Filed At. _____
Object Ident. _____
Ident. By _____
Signature

PLANE COORDINATE POSITION DATA

State _____ Zone _____
X _____
Y _____
Estab. By _____
Agency

Signature David H Klein Title PLS 933 Division _____ Headquarters _____ Date 7/16/84
7100-52-(3/68)

CORNER RECORD (PERPETUATION)

MONUMENT: DESCRIBE NEW MONUMENT SET, OR WORK DONE TO PRESERVE EXISTING MONUMENT

None

ACCESSORIES : DESCRIBE NEW BT'S WITNESS OBJECTS ETC. ESTABLISHED, OR WORK DONE TO PRESERVE EXISTING EVIDENCE

None

Work Done By R Panches Title Party Chief Date 7/9/84 State Registration No. _____
or Agency _____

Certified Cor. Record Prepared ? Yes No _____ Filed At: _____ Date _____

REMARKS

Index File No. R-9 T. 55 R. 33 E. W M. Tract or Surv. No. _____ Cor. sec